

MISSISSIPPI BOARD OF WATER COMMISSIONERS

6-16-66

WATER WELL DRILLERS LOG


Date: 6-14, 1966, Driller: LEACH County Jasper  
 (When well drilled) (Name) (Where well is located)

1) Owner of Land ELMOR Hall  
 (Name)  
Bay Springs, Miss.  
 (Address)  
 2) Location: 1/4, 1/4, Sec. 29 T. R.  
12 miles East of Bay Springs  
 (distance) (direction) (Nearest Town)  
 3) Topography:  (Hilly)  (Flat)  (Level)  
 4) Purpose of Well:  (Domestic Irrigation)  (Municipal, Industrial, Other)

Description & Color of Materials Sand, Clay, Red Clay, Shell, etc.	Thick- ness Feet	Depth Feet
<u>red clay</u>	<u>20</u>	<u>20</u>
<u>Sand &amp; clay</u>	<u>50</u>	<u>70</u>
<u>Blue clay</u>	<u>130</u>	<u>200</u>
<u>Sand</u>	<u>10</u>	<u>210</u>

Information upon completion of well:

1) Diameter 2 inches.  
 2) Total Depth 320 feet.  
 3) Water Level 210 feet below top of ground.  
 4) Cased to 200, Size 2"  
 5) Screen: Size 2", Length 10  
 6) Were any formations sealed against pollution?  
 \_\_\_ yes,  no.

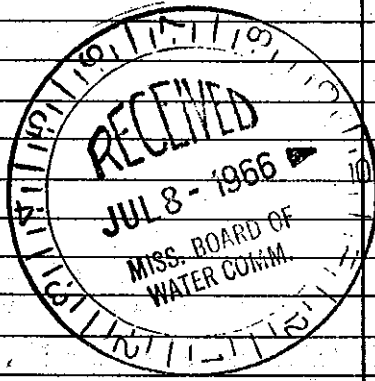

YES depth of formation \_\_\_\_\_  
 Why \_\_\_\_\_  
 Drillers Remarks: Low water level  
 Yield in gpm: 6  
 Size pump: 1 HP  
 Type power: Electric

Total 210'

Mail this copy to Board of Water Commissioners 429 Miss. St. Jackson, Miss.