

Davis Gatlin #2

STATE WELL REPORT

Part 1

Driller's Log

Mississippi Department of Environmental Quality
Office of Land and Water Resources
P.O. Box 2309
Jackson, MS 39225-2309
(601)961-5210
(601)360-0535 (fax)

For Office Use Only:

Well #: M 27
Aquifer: _____
E-Log #: _____

County: Jasper
Permit #: _____
Driller: John W Thompson
Date drilling completed: 10-17-13

State Law requires that this report be prepared by the license holder responsible for the work and filed with the Department at the above address within 30 days of completion of drilling of the well or borehole.

Well Owner Information <i>(Landowner if borehole is not for a water well)</i>	Well or Borehole Location
Owner Name: <u>Eland Energy</u>	Latitude: <u>31°59'16.7"</u> Longitude: <u>88°59'16.8"</u>
Mailing Address: <u>2 Galleria Tower 1455 North</u> <u>Dallas TX 75240</u>	Method of Lat/Long (check one): Conventional Survey _____ USGS quad _____, Hand-held GPS <input checked="" type="checkbox"/> , Survey-grade GPS _____
City _____ State _____ Zip Code _____	NW ¼ NE ¼, Sec <u>29</u> T <u>2N</u> R <u>13E</u>
Telephone No. (____) _____	<u>3</u> Miles <u>SE</u> of <u>Paulding</u> (Distance) (Direction) (Nearest Town)

Well / Borehole Data

Date drilling started: 10-14-13 Date drilling completed: 10-17-13 Hole depth: 560 Hole diameter: 7

Location of the source of any surface water used for drilling: local Creek

Method of dosing and volume of Chlorine used in drilling and development: added 8 gallons bleach

Logs run (circle all applicable): No log run Electric Gamma Ray Density Sonic Neutron Other: _____

Name of organization running log(s): _____

Purpose of borehole (circle one) Water Well Geotechnical/Geological Investigation Ground Source Heat Pump
Seismic Survey Other (describe) rig supply

If drilling is not related to water well construction, skip the remainder of this block

Purpose of Well (circle all applicable): Home Industrial Public Supply Irrigation Fish Culture
Other (describe): rig supply

If a flowing well, method of flow regulation: Valve _____ Other (describe) _____

Static Water Level: 257 feet [above or below] land surface Date measured: 10-17-13
(circle one)

Method of measurement (circle one): Steel tape Electric tape Air line Other (describe): _____

Well depth: 540 Well grouted to a depth of: 20 feet Type of grout (circle one): Neat Cement Bentonite Mix

Casing length: 480 feet Casing diameter: 4 inches Type of casing: PVC

Screen length: 60 feet Screen diameter: 4 inches Type of screen: PVC slotted

Screen slot size: 0.008 inches Setting depth: From 480 feet to 540 feet

Type of completion (circle all applicable): Gravel packed Underreamed Open hole Natural Development

Other (describe): _____

Top of lap pipe or reduction in casing: _____ feet


If telescoped or more than one screen, describe on next page

County: Jasper
 Permit #: _____

For Office Use Only:
 Well #: M-27

The sketch below only required for water wells
If well telescopes, show depths on sketch.

Description of formations encountered must be provided for all wells
and boreholes, unless specifically exempted by regulations

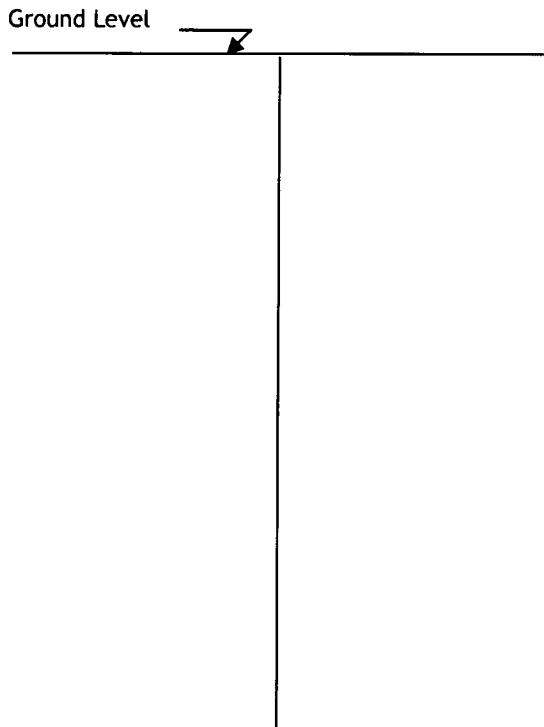

Description of Formations Encountered	From (depth)	To (depth)
blue clay	Ground level	260
clay (shale)	260	340
clay & sand strips	340	440
sand & clay	440	540
Clay	540	560

If more than one screen, show location of each on sketch

Sketch the property layout and include the following:
 1) the well location
 2) any permanent structures on the property that may aid in locating the well
 3) any roads, power lines, or other items that may aid in locating the property and the well
 4) north arrow

RECEIVED
 BY: OLWR

Landowner Name: Eland Energy

I HEREBY CERTIFY that the well/borehole was drilled, constructed, and completed in accordance with all applicable requirements of the Mississippi Department of Environmental Quality and the Mississippi Department of Health regulations, if applicable, and state laws.

John W. Hampson 0-679 10-25-13 John W. Hampson
 Print Name of Responsible Licensee and License No. Date Signature of Licensee

STATE WELL REPORT

Part 2

Pump Installer's Completion Report
Mississippi Department of Environmental Quality
Office of Land and Water Resources
P.O. Box 2309
Jackson, MS 39225-2309
(601)961-5210
(601) 360-0535 (fax)

For Office Use Only:

Well #: M37
Aquifer: _____

County: Jasper
Permit #: _____
Driller: John W Thompson
Date completed: 10-17-13

Copy information from block on Part 1

This part of the report must be completed by a licensed water well contractor or a licensed pump installer. A copy of Part 1 of the report must be attached and both parts filed with the Department at the above address within 30 days of well completion.

Well Owner Information			Well Location		
Owner Name: <u>Eland Energy</u>			Latitude: <u>31°59'16.7"</u> Longitude: <u>88°59'16.8"</u>		
Mailing Address: <u>2 Galleria Tower 1455 Noel Rd</u> <u>Dallas TX 75240</u>			Method of Lat/Long (check one): Conventional Survey _____, USGS quad _____, Hand-held GPS <input checked="" type="checkbox"/> , Survey-grade GPS _____		
City	State	Zip Code	<u>1/4</u>	<u>1/4</u> , Sec <u>29</u>	T <u>2N</u> R <u>3E</u>
Telephone No. (____)			<u>3</u> Miles	<u>SE</u> of	<u>Paulding</u>
			(Distance)	(Direction)	(Nearest Town)

Pump Type (circle one)
 Submersible Turbine Air Lift Centrifugal Flowing Well Jet Piston Rotary Other (describe): _____
Date Pump Installed: 10-17-13 Rated Pump Capacity: 35 Gallons Per Minute
Is This Pump (circle one): New Repaired Replacement

Power Type (circle one)
 Electric Diesel Gasoline Natural Gas Tractor PTO Windmill Other (describe): _____
Horse Power Rating of Motor: 7.5 Setting Depth: 320 feet Number of Stages: _____

Pump Test Data for Non Flowing Well
Date Well Tested: 10-17-13 Duration of Pump Test (minimum 4 hours): 4 hours
Static Water Level (A): 257 Feet Below Land Surface Pumping Water Level (B): 270 Feet Below Land Surface
Drawdown [(B) - (A)]: 13 Feet Below Land Surface Test Pumping Rate: 25 Gallons Per Minute
Method of measurement (circle one): Steel tape Electric tape Air line Other (describe): _____

Pump Test Data for Flowing Well
Measured shut in head: _____ feet.
Well yielded _____ GPM with a drawdown of _____ feet after _____ hours of pumping

Meter Installation
Meter Manufacturer: _____ Meter Serial Number: _____
Meter Model Number/Name: _____ Type of Meter: _____
Totalizer Register Unit and Multiplier Factor (AF x .001, gal x 1000, etc): _____
Installation Date: _____ Meter installed by: _____
Is This Meter (circle one): New Repaired Replacement
Important: By submitting the above information you are certifying that this meter was installed to manufacturer standards. For agricultural wells, a list of approved meters is on the MDEQ website.

I HEREBY CERTIFY that the above statements are true to the best of my knowledge.
Print Name of Pump Installer and License No. (if applicable) _____ Date _____ Signature of Pump Installer _____