

JASPER
 N
 5-21-76

MISSISSIPPI
 BOARD OF WATER COMMISSIONERS
 416 North State Street
 Jackson, Mississippi 39201

WATER WELL DRILLERS LOG


May 21 1976 J. K. Barnes Water Co. Jasper
 date well completed firm name county well located

LANDOWNER	description of formations encountered	from	to
Tommye Boyd	Red clay	0	12
Ret. 1	yellow clay	12	24
Bay Springs Miss	(fine yellow) sand	24	36
(mailing address)	blue clay	36	92
	fine blue sand	92	131

WELL LOCATION: 10
 sec. 25 T. 2 R. 12
 4 miles S. E. of Bay Springs
 (distance) (direction) (nearest town)

WELL PURPOSE: House
 (home, irrigation, municipal, industrial)

- WELL COMPLETION DATA:
- (1) diameter (inches) 2
 - (2) total depth (feet) 131
 - (3) static water level (feet) 60 below above top of ground.
 - (4) casing Galv. (material), (depth)
2" if telescope see back. (size)
 - (5) screen 4 (length) (depth to top)
04 (size) Stainless S. (material)
 - (6) pump L (HP) 8 (yield gpm)
Elec. (type power)
 - (7) electric log no (yes or no)
 (organization running log)
 - (8) how well bottom plugged Wash blue

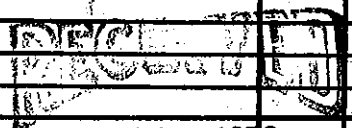

JUN 10 1976

DRILLERS REMARKS:
 MISS. BD. OF WATER COMM