

MISSISSIPPI BOARD OF WATER COMMISSIONERS

WATER WELL DRILLERS LOG

AS PER N 300 0
10-14-60

Date: 10-14, 1960, Driller: W. K. Barnes County Jasper
(Name)

(1) Owner of Land	Description & Color of Materials Sand, Clay, Red Clay, Shell, etc.	Thick- ness Feet	Depth Feet
Jack Mc Cusky (Name)	Red clay	0	20
Bayspring Miss (Address)	yellow clay	20	45
(2) Location: 1/4, 1/4, Sec. 17 T. R.	Blue mud	45	85
4 miles South of Bayspring (distance) (direction) (Nearest town)	Lign Rock	85	100
(3) Topography: Hilly (Hilly) (Flat) (Level)	Blue mud	100	180
(4) Purpose of Well: Home use (Domestic Irrigation Municipal, Industrial, Other)	Blue sand	190	217


Information upon completion of well:

- (1) Diameter 2 inches.
- (2) Total Depth 217 feet.
- (3) Water Level 50 feet below top of ground.
- (4) Cased to 205, Size 2.
- (5) Screen: Size 8.0, Length 12.
- (6) Were any formations sealed against pollution?
_____ yes, _____ no.

If YES depth of formation _____

Why _____

Drillers Remarks: _____

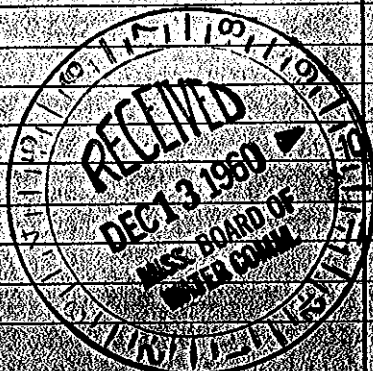

(Use Back Side)