

JASPER MISSISSIPPI BOARD OF WATER COMMISSIONERS

6 N6

3

8-9-65 WATER WELL DRILLERS LOG

Date: 8-9, 1965, Driller: Brown Brath County Jasper
(Name)

(1) Owner of Land: Elise Ingram
(Name)
Bay Springs
(Address) ✓

(2) Location: 1/4, 1/4, Sec. 7 T. 1 R. 10
3 miles South West of Bay Springs
(distance) (direction) (Nearest Town)

(3) Topography: Hilly
(Hilly) (Flat) (Level)

(4) Purpose of Well: Home
(Domestic Irrigation
Municipal, Industrial, Other)

Description & Color of Materials Sand, Clay, Red Clay, Shell, etc.	Thick- ness Feet	Depth Feet
Clay sand	0	20
shale	20	40
ll	40	60
ll	80	80
sand	80	100
shale	100	20

Information upon completion of well:

(1) Diameter 4 1/2 inches.

(2) Total Depth 100 feet.

(3) Water Level 62 feet below top of ground.

(4) Cased to 95, Size 2


(5) Screen: Size 2 1/8, Length 5 ft

(6) Were any formations sealed against pollution?
_____ yes, No no.

If YES depth of formation _____

Why _____

Drillers Remarks: _____

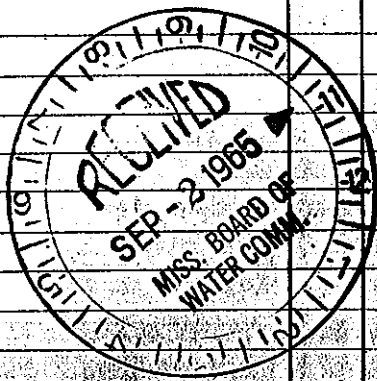

Well No. 3

(Use Back Side)