

MISSISSIPPI BOARD OF WATER COMMISSIONERS

WATER WELL DRILLERS LOG

JASPER
S N 8
22-60

5300

Date: 9-22, 1960, Driller: W. K. Barnes County Jasper
(Name)

(1) Owner of Land	Description & Color of Materials Sand, Clay, Red Clay, Shell, etc.	Thick- ness Feet	Depth Feet
<u>J. S. Graham</u> (Name) <u>Stringer Miss. Rt. 1</u> (Address)	<u>Red Clay</u>	<u>0</u>	<u>15</u>
	<u>Blue shale</u>	<u>15</u>	<u>100</u>
	<u>water sand</u>	<u>10</u>	<u>120</u>
(2) Location: <u>1/4</u> , <u>1/4</u> , Sec. <u>26</u> T. <u>1</u> R. <u>10</u> <u>3</u> miles <u>East</u> of <u>Stringer</u> (distance) (direction) (Nearest Town)			
(3) Topography: <u>Hilly</u> (Hilly) (Flat) (Level)			
(4) Purpose of Well: <u>Chicken House</u> (Domestic Irrigation Municipal, Industrial, Other)			


Information upon completion of well:

- (1) Diameter 2 inches.
- (2) Total Depth 120 feet.
- (3) Water Level 40 feet below top of ground.
- (4) Cased to 114, Size 2.
- (5) Screen: Size 80, Length 6.
- (6) Were any formations sealed against pollution?
_____ yes, _____ no.

If YES depth of formation _____

Why _____

Drillers' Remarks: _____

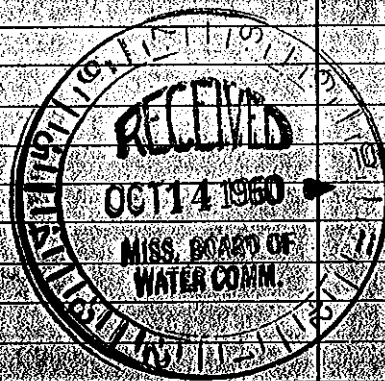

(Use Back Side)

Well No.