

12 3 130 315620N 0891800 TMOA

Jasper  
N10  
8-68

MISSISSIPPI  
BOARD OF WATER COMMISSIONERS  
416 North State Street  
Jackson, Mississippi 39201

CODED

WATER WELL DRILLERS LOG

8-21 date well completed  
W.K. Barnes water well firm name  
Jasper county well located

LANDOWNER: Thomas Parker  
Rt. 1  
Stringer miss.  
(mailing address)


description of formations encountered	from	to
Red clay	0	10
Red Sand	10	24
yellow clay	24	50
Course Water Sand	60	68

WELL LOCATION: 10E  
sec. 8-T-1-N R. 13E  
3 miles north of Stringer  
(distance) (direction) (nearest town)

WELL PURPOSE: Home use  
(home, irrigation, municipal, industrial)

- WELL COMPLETION DATA:
- (1) diameter (inches) 2
  - (2) total depth (feet) 68
  - (3) static water level (feet) 40 below top of ground.
  - (4) casing Galv. 63 (material) (depth)  
1 1/4" (size) If telescope see back.
  - (5) screen 5' (length) (depth to top)  
8 slot, Stainless Steel (size) (material)
  - (6) pump 3/4 (HP) 10 (yield gpm)  
Elec (type power)
  - (7) electric log no. (yes or no)
  - (8) how well bottom plugged wash valve

CODED

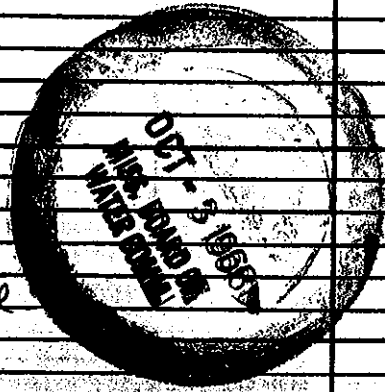

DRILLERS REMARKS: