

JASPER Co  
 N 23  
 MISSISSIPPI BOARD OF WATER COMMISSIONERS

5-9-66

WATER WELL DRILLERS LOG

OK JAC  
 CODED

Date: 5-9, 1964, Driller: LEACH County: [unclear]  
 (When well drilled) (Name) (Where well is located)


1) Owner of Land: P.P. LADNER (Name)  
 Boggs Springs, Miss. (Address)  
 2) Location: 1/4, 1/4, Sec. 10 NE (Nearest Town)  
 6 miles South Boggs Springs (distance) (direction)  
 3) Topography: [unclear] (Hilly) (Flat) (Level)  
 4) Purpose of Well: [unclear] (Domestic Irrigation) (Municipal, Industrial, Other)

Description & Color of Materials Sand, Clay, Red Clay, Shell, etc.	Thick- ness Feet	Depth Feet
Red clay	80	20
gravel	12	32
Blue clay	72	110
Sand	21	131

CODED

Information upon completion of well:

1) Diameter 2 inches.  
 2) Total Depth 131 feet.  
 3) Water Level 30 feet below top of ground.  
 4) Cased to 124, Size 2"  
 5) Screen: Size 2 1/2", Length 5'  
 5) Were any formations sealed against pollution?  
 \_\_\_\_\_ yes, \_\_\_\_\_ no.

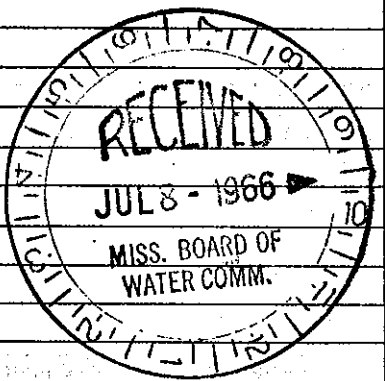

YES depth of formation \_\_\_\_\_  
 /hy \_\_\_\_\_  
 Drillers Remarks: \_\_\_\_\_  
 Yield in gpm: 15  
 Size pump: 1/2 H.P.  
 Type power: electric

Total 131

File this copy to Board of Water Commissioners 429 Miss. St. Jackson, Miss.