

MISSISSIPPI DEPARTMENT OF NATURAL RESOURCES

Bureau of Land and Water Resources


Southport, Mississippi

P.O. Box 10631

Jackson, Mississippi 39208

WATER WELL DRILLERS LOG

Griner Drilling Service, Inc.

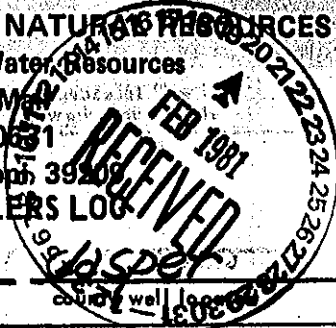

JASPER
N 40
2/13/81
2-13-81

date well completed

firm name

county well logs

LANDOWNER:
Spooner Petroleum
1850 Deposit Guaranty Plaza
Jackson, Ms. 39201
(mailing address)

description of formations encountered	from	to
clay, sand, rocks	0	800
sand, clay, mostly sand	800	835
sand	835	872

WELL LOCATION: 900' S + 200' W of
1 sec. 1 T. 10 N. R. 10 E. NE/4
Ja. Alexander Bay Springs
1/2 mi. (direction) (nearest town)

WELL PURPOSE: oil field supply
(home, irrigation, municipal, industrial)

WELL COMPLETION DATA:

(1) diameter (inches) 3"

(2) total depth (feet) 872'

(3) static water level (feet) 150' (below top of ground)

(4) casing steel, 872' (material) (depth)
3" (size) if telescope see back.

(5) screen 42' 830' (length) (depth to top)
3" perforated (size) (material)

(6) pump (HP) 75 (yield gpm)
AC (type power)

(7) electric log (yes or no)

(8) how well bottom plugged orange
peel

DEPT. OF NATURAL RESOURCES
BUREAU OF LAND & WATER RESOURCES

FEB 20 1981

RECEIVED

DRILLERS REMARKS: