

N47
 JASPER
 8-30-85

MISSISSIPPI
 BOARD OF WATER COMMISSIONERS
 416 North State Street
 Jackson, Mississippi 39201

CODED

WATER WELL DRILLERS LOG

8-30 85 A-1 Drilling Co. Inc Jasper
 date well completed firm name county well located

LANDOWNER: Paul Myrick
 Route 1, Box 349A
 Stringer Miss 39481
 (mailing address)


description of formations encountered	from	to
Top soil	0'	1'
Red sandy clay	1'	20'
Sand w/stratified pea gravel	20'	68'
white clay	68'	70'

WELL LOCATION:
 sec. 31 T. 1 N R. 10 E
 2 1/2 miles NW of Stringer
 (distance) (direction) (nearest town)

WELL PURPOSE: Home
 (home, irrigation, municipal, industrial)

CODED

- WELL COMPLETION DATA:
- (1) diameter (inches) 4"
 - (2) total depth (feet) 70
 - (3) static water level (feet) 47 below top of ground.
 - (4) casing Sch 40 PVC, 63' (material) (depth)
 (size) If telescope see back.
 - (5) screen 5' length, 63' depth to top
 4" Stainless Steel (size) (material)
 - (6) pump 3/4 HP, 17 (yield gpm)
 220V 1φ (type power)
 - (7) electric log no (yes or no)
 - (organization running log)
 - (8) how well bottom plugged BWC

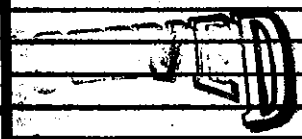

SEP 23 1985

Department of Natural Resources
 Bureau of Land & Water

DRILLERS REMARKS: Set owners
 bears 3/4 HP out on 60 ft
 sch 40 PVC T & C w/ brass
 seal 1/2 ft above pump