

County: Jasper (061)
 Permit #: _____
 Driller: A-1 Drilling Servs Inc
 Date drilling completed: 10-30-14

STATE WELL REPORT

Part 1 Driller's Log

Mississippi Department of Environmental Quality
 Office of Land and Water Resources
 P.O. Box 2309
 Jackson, MS 39225-2309
 (601)961-5210
 (601)360-0535 (fax)

For Office Use Only:
 Well #: 24
 Aquifer: _____
 E-Log #: _____

State Law requires that this report be prepared by the license holder responsible for the work and filed with the Department at the above address within 30 days of completion of drilling of the well or borehole.

Well Owner Information (Landowner if borehole is not for a water well)	Well or Borehole Location
Owner Name: <u>Pilgrim Const. Co. (Boardwalk Pipeline)</u>	Latitude: <u>31° 54' 26" N</u> Longitude: <u>88° 57' 40" W</u>
Mailing Address: <u>PO Drawer 4E</u>	Method of Lat/Long (check one): Conventional Survey _____
<u>Sandersville</u> <u>MS</u> <u>39471</u>	USGS quad _____ Hand-held GPS <input checked="" type="checkbox"/> Survey-grade GPS _____
City State Zip Code	<u>5W 1/4 SW 1/4, Sec 22 T 1N R 10W</u>
Telephone No. (601) <u>426-3118</u>	<u>+ 2</u> Miles <u>E</u> of <u>Heidelberg</u>
	(Distance) (Direction) (Nearest Town)

Well / Borehole Data

Date drilling started: 10-21-14 Date drilling completed: 10-30-14 Hole depth: 500' Hole diameter: 6 3/4"

Location of the source of any surface water used for drilling: Philadelphia Water Assn.

Method of dosing and volume of Chlorine used in drilling and development: _____

Logs run (circle all applicable): No log run Electric Gamma Ray Density Sonic Neutron Other: _____

Name of organization running log(s): _____

Purpose of borehole (circle one): Water Well Geotechnical/Geological Investigation Ground Source Heat Pump

Seismic Survey Other (describe) _____

If drilling is not related to water well construction, skip the remainder of this block

Purpose of Well (circle all applicable): Home Industrial Public Supply Irrigation Fish Culture

Other (describe): _____

If a flowing well, method of flow regulation: Valve _____ Other (describe) _____

Static Water Level: 183.5 feet (above or below) land surface Date measured: 10-29-14

Method of measurement (circle one): Steel tape Electric tape Air line Other (describe): Sonic

Well depth: 445' Well grouted to a depth of: 11 feet Type of grout (circle one): Neat Cement Bentonite Mix

Casing length: 425 feet Casing diameter: 4 inches Type of casing: PVC

Screen length: 20 feet Screen diameter: 4 inches Type of screen: Slotted PVC

Screen slot size: .006 inches Setting depth: From 425 feet to 445 feet

Type of completion (circle all applicable): Gravel packed Underreamed Open hole Natural Development

Other (describe): _____

Top of lap pipe or reduction in casing: _____ feet

If telescoped or more than one screen, describe on next page


Form: OLWR-SWR-1A (4/13)

County: Jasper
 Permit #: _____

For Office Use Only:
 Well #: 624

The sketch below only required for water wells

If well telescopes, show depths on sketch.

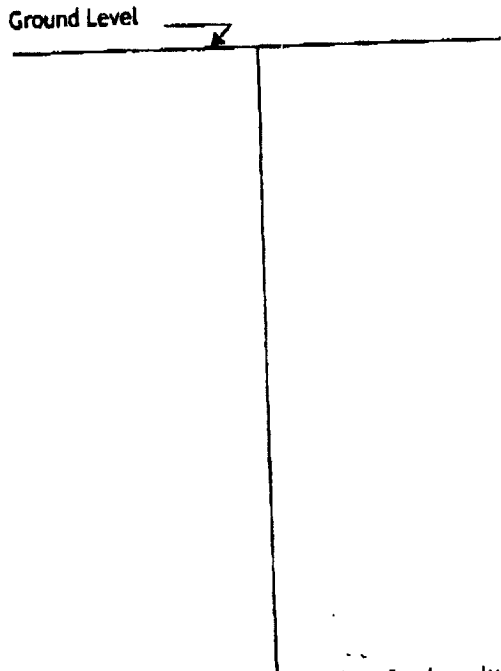

Description of formations encountered must be provided for all wells and boreholes, unless specifically exempted by regulations

Description of Formations Encountered	From (depth)	To (depth)
Red + white clay	Ground level	7
Brown clay	7	10
Tan clay	10	23
Dark gray clay	23	70
Gray green clay	70	300
clay w/ hard streaks	300	318
Gray clay	318	361
clay w/ hard streaks	361	372
Sand + sea shells	372	381
Sandy clay, brown	381	397
Sand	397	401
Sand + clay mixed	401	417
Sand	417	420
Clay	420	423
Sand	423	451
Clay	451	456
Sand + clay streaks	456	475
Sand	475	481
Clay dark gray	481	500

If more than one screen, show location of each on sketch

Sketch the property layout and include the following:
 1) the well location
 2) any permanent structures on the property that may aid in locating the well
 3) any roads, power lines, or other items that may aid in locating the property and the well
 4) north arrow

Landowner Name: Boardwalk Pipeline

I HEREBY CERTIFY that the well/borehole was drilled, constructed, and completed in accordance with all applicable requirements of the Mississippi Department of Environmental Quality and the Mississippi Department of Health regulations, if applicable, and state laws.

Mike Baughman 587 11-17-14 Mike Baughman
 Print Name of Responsible Licensee and License No. Date Signature of Licensee

Form: OLWR-SWR-1A (4/13)

STATE WELL REPORT

Part 2

Pump Installer's Completion Report

Mississippi Department of Environmental Quality
Office of Land and Water Resources
P.O. Box 2309
Jackson, MS 39225-2309
(601)961-5210
(601) 360-0535 (fax)

For Office Use Only:

Well #: 24

Aquifer: _____

County: Jasper
 Permit #: _____
 Driller: A-1 Drilling Serv. Inc.
 Date completed: 10-30-14
 Copy information from block on Part 1

This part of the report must be completed by a licensed water well contractor or a licensed pump installer. A copy of Part 1 of the report must be attached and both parts filed with the Department at the above address within 30 days of well completion.

Well Owner Information	Well Location
Owner Name: <u>Pilgrim Const. Co. (Bourbonville, La.)</u>	Latitude: <u>31° 54' 26" N</u> Longitude: <u>98° 51' 40" W</u>
Mailing Address: <u>PO. Drawer 4E</u>	Method of Lat/Long (check one): Conventional Survey _____ USGS quad _____, Hand-held GPS <u>X</u> , Survey-grade GPS _____
<u>Sandersville</u> <u>MS</u> <u>39417</u> City State Zip Code	<u>SW 1/4 SW 1/4, Sec 22 T 1 N R 10 W 13 E</u> <u>2</u> Miles <u>E</u> of <u>Heidelberg</u> (Distance) (Direction) (Nearest Town)
Telephone No. <u>(601) 426-3118</u>	

Pump Type (circle one)

Submersible Turbine Air Lift Centrifugal Flowing Well Jet Piston Rotary Other (describe): _____

Date Pump Installed: 10-30-14 Rated Pump Capacity: 18 Gallons Per Minute

Is This Pump (circle one): New Repaired Replacement

Power Type (circle one)

Electric Diesel Gasoline Natural Gas Tractor PTO Windmill Other (describe): _____

Horse Power Rating of Motor: 3 Setting Depth: 273 feet Number of Stages: 19

Pump Test Data for Non Flowing Well

Date Well Tested: _____ Duration of Pump Test (minimum 4 hours): _____ hours

Static Water Level (A): 183.5 Feet Below Land Surface Pumping Water Level (B): _____ Feet Below Land Surface

Drawdown [(B) - (A)]: _____ Feet Below Land Surface Test Pumping Rate: _____ Gallons Per Minute

Method of measurement (circle one): Steel tape Electric tape Air line Other (describe): Sonic

Pump Test Data for Flowing Well

Measured shut in head: _____ feet.

Well yielded _____ GPM with a drawdown of _____ feet after _____ hours of pumping

Meter Installation

Meter Manufacturer: _____ Meter Serial Number: _____

Meter Model Number/Name: _____ Type of Meter: _____

Totalizer Register Unit and Multiplier Factor (AF x .001, gal x 1000, etc): _____

Installation Date: _____ Meter installed by: _____

Is This Meter (circle one): New Repaired Replacement

Important: By submitting the above information you are certifying that this meter was installed to manufacturer standards. For agricultural wells, a list of approved meters is on the MDEQ website.

I HEREBY CERTIFY that the above statements are true to the best of my knowledge.

Mike Baughman 587 11-17-14 [Signature]
 Print Name of Pump Installer and License No. (If applicable) Date Signature of Pump Installer

Form: OLWR-SWR-1B (4/13)