

MISSISSIPPI BOARD OF WATER COMMISSIONERS

WATER WELL DRILLERS LOG

10-25-60

Date: 10-25, 1960 Driller: W. K. Barnes County Jasper

(Name)

(1) Owner of Land: D. R. Pittman  
(Name)

Hedberg Rt. # 1  
(Address)

(2) Location: 1/4, 1/4, Sec. 16 1N 12E T R  
7 miles West of Hedberg  
(distance) (direction) (Nearest Town)

(3) Topography: Hilly  
(Hilly) (Flat) (Level)

(4) Purpose of Well: Home use  
(Domestic Irrigation, Municipal, Industrial, Other)

Description & Color of Materials  
Sand, Clay, Red Clay, Shell, etc.

Thick-ness  
Feet

Depth  
Feet

yellow clay	6	15
Blue mud	13	375
Sea shells	375	410
Coar sand	410	430


Information upon completion of well:

- (1) Diameter 2 inches.
- (2) Total Depth 430 feet.
- (3) Water Level 110 feet below top of ground.
- (4) Cased to 412, Size 2
- (5) Screen: Size 80, Length 18
- (6) Were any formations sealed against pollution?  
yes, no.

If YES depth of formation

Why

Drillers Remarks

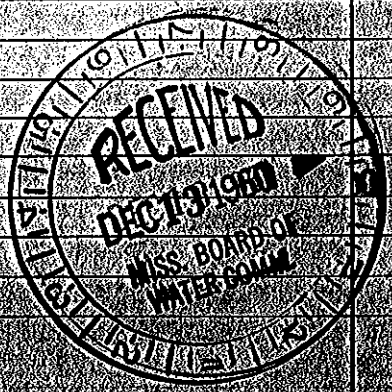

(Use Back Side)

Mail this copy to Board of Water Commissioners 429 Miss. St. Jackson, Miss.