

FAS PER MISSISSIPPI BOARD OF WATER COMMISSIONERS

WATER WELL DRILLERS LOG

Date: 6-25-63, 1963, Driller: C. Q. Clark County Jasper

(1) Owner of Land: R. R. Waldrop
 (Name)
Rt #1 Heidelberg Miss
 (Address)

(2) Location: 1/4, 1/4, Sec. 23 T1 R12
4 miles West of Heidelberg
 (distance) (direction) (Nearest Town)

(3) Topography: Flat
 (Hilly) (Flat) (Level)

(4) Purpose of Well: Irrigation
 (Domestic Irrigation, Municipal, Industrial, Other)

Description & Color of Materials Sand, Clay, Red Clay, Shell, etc.	Thick- ness Feet	Depth Feet
<u>0-30 yellow Clay</u>	<u>30</u>	
<u>30-50 Blue Clay</u>	<u>20</u>	
<u>50-75 yellow Clay</u>	<u>25</u>	
<u>75-350 Blue Clay</u>	<u>275</u>	
<u>350-390 Sand Blue Clay</u>	<u>40</u>	
<u>390-410 Sand + clay</u>	<u>20</u>	
<u>410-450 Blue Clay</u>	<u>40</u>	
<u>450-495 Sand</u>	<u>45</u>	


Information upon completion of well:

(1) Diameter 2 inches.
 (2) Total Depth 495 feet.
 (3) Water Level 160 feet below top of ground.
 (4) Cased to 475, Size 2
 (5) Screen: Size 1/4, Length 20
 (6) Were any formations sealed against pollution?
no

If YES depth of formation _____

Why _____

Drillers Remarks: _____

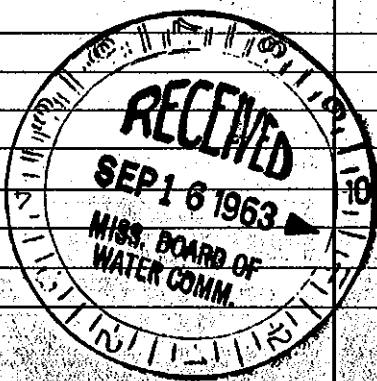

(Use Back Side)

Well No. _____

Mail this copy to Board of Water Commissioners 429 Miss. St. Jackson, Miss.