

MISSISSIPPI BOARD OF WATER COMMISSIONERS

WATER WELL DRILLERS LOG

JAS PER  
P/O  
7-65

Low Cholesterol?

Date: July, 1965, Driller: Peoples Drilling Co. Jasper  
(Name)

(1) Owner of Land: Half McDonald  
(Name)  
Hiedleburg, Miss.  
(Address)  
(2) Location: NE 1/4, NW 1/4, Sec. 35 T1R12  
7 miles W of Hiedleburg  
(distance) (direction) (Nearest Town)  
(3) Topography: Hilly to Flat  
(Hilly) (Flat) (Level)  
(4) Purpose of Well: Community  
(Domestic Irrigation  
Municipal, Industrial, Other)


Description & Color of Materials Sand, Clay, Red Clay, Shell, etc.	Thick- ness Feet	Depth Feet
yellow sandy clay	18	18
yellow sand		
small clay breaks	75	93
sand rock	1	94
lime & limeroch	66	160
blue clay & lumber	275	435
white lime & rock	85	520
white sand	92	612
blue clay & sand breaks	78	690
lime & limeroch	140	830
brown clay & sand	30	860
sand	30	890

Information upon completion of well:

(1) Diameter 4 inches.  
(2) Total Depth 890 feet.  
(3) Water Level 235 feet below top of ground.  
(4) Cased to 820', Size 4"  
(5) Screen: Size 2 1/2", Length 18'  
(6) Were any formations sealed against pollution?  
\_\_\_\_\_ yes, \_\_\_\_\_ no.

If YES depth of formation 820  
13  
83  
Why \_\_\_\_\_  
Drillers Remarks: \_\_\_\_\_

not now owned by  
Suey.

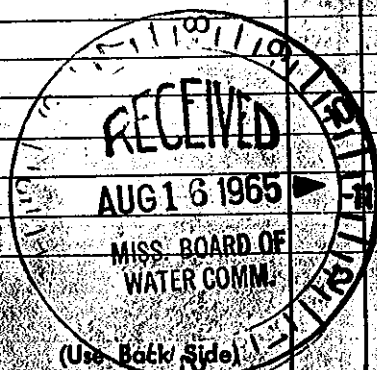

Well No.