

Jasper
P7
7-68

MISSISSIPPI
BOARD OF WATER COMMISSIONERS CODED
416 North State Street
Jackson, Mississippi 39201

WATER WELL DRILLERS LOG

7-9-68 19 McDonald + Hill JASPER
date well completed firm name county well located

LANDOWNER: GOLF OIL CO
HEIDELBERG MISS

(mailing address)

WELL LOCATION:


sec. 28 T-1 N R-12 E
S W
3 miles WEST of Heidelberg
(distance) (direction) (nearest town)

WELL PURPOSE: HOME
(home, irrigation, municipal, industrial)

WELL COMPLETION DATA:

- (1) diameter (inches) 4"
- (2) total depth (feet) 360
- (3) static water level (feet) 96 below top of ground.
- (4) casing BLK 190' (material) (depth)
4" (size) if telescope see back.
- (5) screen 15 345 (length) (depth to top)
2" PVC (size) (material)
- (6) pump 1 15 (HP) (yield gpm)
220 (type power)
- (7) electric log NO (yes or no)
NO (organization running log)
- (8) how well bottom plugged VALVE

description of formations encountered	from	to
Clay	0	12
Humbo Clay	12	90
YAZOO Clay	90	140
Shale	140	252
Shale to Time Rock	252	365
Sand	365	360

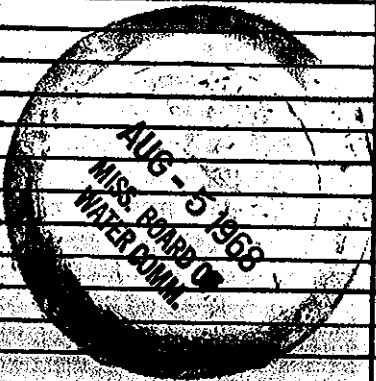

DRILLERS REMARKS:

