

JASPER
 D 2001
 4/18/81

MISSISSIPPI
 BOARD OF WATER COMMISSIONERS
 416 North State Street
 Jackson, Mississippi 39201

WATER WELL DRILLERS LOG

date well completed: 4/18/81
 firm name: RAY WEST DRIG
 county well located: JASPER

LANDOWNER:
 Bobby Norman
 Bay Springs
 (mailing address)

WELL LOCATION:
 sec. 2 T. 1 N. R. 12 E.
 6 miles SE of Bay Springs
 (distance) (direction) (nearest town)

description of formations encountered	from	to
SANDY CLAY	0	10
SAND	10	32
CLAY	32	48
SAND	48	80

WELL PURPOSE: Home
 (home, irrigation, municipal, industrial)

WELL COMPLETION DATA:

(1) diameter (inches) 8"

(2) total depth (feet) 80'

(3) static water level (feet) 68' below top of ground

(4) casing PVC 75' (material) (depth)
 (size) If telescope see back


(5) screen 5' 75' (length) (depth to top)
 5" PVC (size) (material)

(6) pump 1 HP 6 (type power) (yield gpm)
 RED

(7) electric log NO (yes or no)

(organization running log)

(8) how well bottom plugged
 UNDER VALVE

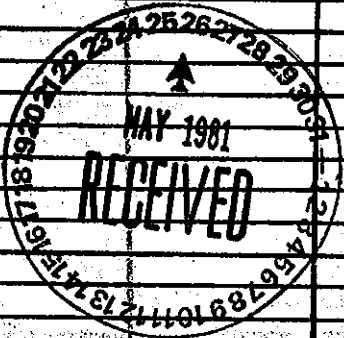

DRILLERS REMARKS: