

el log 113

Jasper  
94  
2-68  
Elec Log

MISSISSIPPI  
BOARD OF WATER COMMISSIONERS  
416 North State Street  
Jackson, Mississippi 39201

CODED

WATER WELL DRILLERS LOG

2-2-68 19 MCDONALD + HILL JASPER  
date well completed firm name county well located

LANDOWNER: BEAVER DAM  
STAFFORD SPRINGS  
(mailing address)


WELL LOCATION:  
sec. 23 T. 14 N. R. 13 E  
STAFFORD SPRINGS  
(distance) miles (direction) of (nearest town)

WELL PURPOSE: TEST  
(home, irrigation, municipal, industrial)

WELL COMPLETION DATA:  
(1) diameter (inches) 4" TEST HOLE  
(2) total depth (feet) 1460  
(3) static water level (feet) 253' below top of ground.  
(4) casing BLACK 100' (material) (depth)  
4" If telescope see back.  
(5) screen TEST No 1 20' 760' (length) (depth to top)  
TEST No 2 20' 860' BRASS (size) (material)  
(6) pump SWAB TYPE 351 (HP) (yield gpm)

GAS ENGINE  
(type power)  
(7) electric log YES (yes or no)  
U.S. GEOLOGICAL SURVEY (organization running log)  
(8) how well bottom plugged VALVE

description of formations encountered	from	to
CLAY ST SAND	0	62
YELLOW CLAY	62	102
LIME ROCK ST SHALE	102	140
SHALE	140	495
FINE SAND	495	510
BROWN SHALE	510	540
FINE SAND	540	555
SANDY	555	570
SHALE	570	750
FINE RED SAND	750	800
HARD SHALE	800	840
SAND No 10 = 12	840	890
SHALE	890	1140
SANDY	1140	1160
SHALE	1160	1460

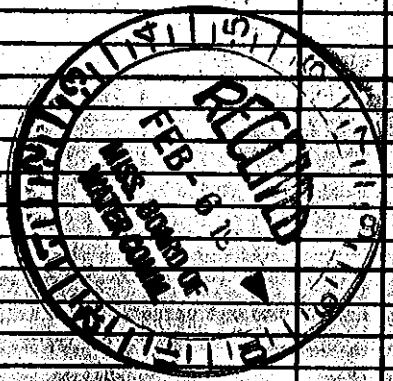

DRILLERS REMARKS:  
NO DATA ON BACK