

JASPER MISSISSIPPI BOARD OF WATER COMMISSIONERS

WATER WELL DRILLERS LOG

CODED

Date: Feb 11, 1961, Driller: W. Porter & Son County Jasper

(1) Owner of Land: Maria McNeil Moore
 (Name)
At 3 Shubuta Miss
 (Address) 23

(2) Location: 1/4, 1/4, Sec. 26 T1 R13
In Clifton Springs, Miss
 (distance) (direction) (Nearest Town)

(3) Topography: Hilly
 (Hilly) (Flat) (Level)

(4) Purpose of Well: Domestic
 (Domestic Irrigation
 Municipal, Industrial, Other)

Description & Color of Materials Sand, Clay, Red Clay, Shell, etc.	Thick- ness Feet	Depth Feet
Clay	20	20'
loose lignite layers	6	26'
blue shale with occasional limestone	434	460
fine clean sand	20	480
sand & shale	15	495
sand	21	515
stopped on shale		515

Information upon completion of well:

(1) Diameter 2 inches.

(2) Total Depth 515 feet.

(3) Water Level 160 feet below top of ground.

(4) Cased to 483, Size 2

(5) Screen: Size 1 1/4, Length 18
70 gauge


(6) Were any formations sealed against pollution?
 yes, X no.

CODED

If YES depth of formation _____

Why _____

Drillers Remarks: _____

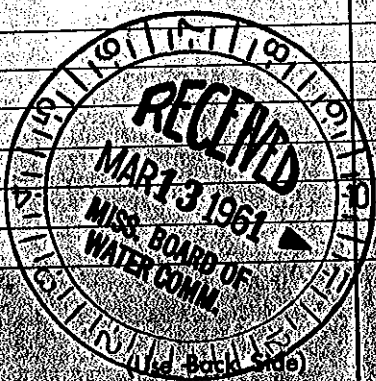

1 this copy to Board of Water Commissioners 429 Miss. St. Jacks