

WATER WELL DRILLERS LOG

CODED

Date: 9/12, 1961, Driller: O.P. Clark County: Jasper
(Name)

(1) Owner of Land: W.W. Martin
(Name)
Wassburg Miss
(Address)
 (2) Location: 1/4, 1/4, Sec. 23 ^{1N 13E} T R
1 miles East of Wassburg
(distance) (direction) (Nearest Town)
 (3) Topography: (Hilly) (Flat) (Level)
 (4) Purpose of Well: fall out shelter
(Domestic Irrigation Municipal, Industrial, Other)

Description & Color of Materials Sand, Clay, Red Clay, Shell, etc.	Thick- ness Feet	Depth Feet
<u>0-18 Red Sandy Clay</u>	<u>18</u>	<u>18</u>
<u>18-70 Red + Gravel</u>	<u>52</u>	<u>70</u>
<u>70-75 Blue Clay</u>	<u>5</u>	<u>75</u>

CODED


Information upon completion of well:

(1) Diameter 2 inches.
 (2) Total Depth 70 feet.
 (3) Water Level 60 feet below top of ground.
 (4) Cased to 65, Size 2
 (5) Screen: Size 1/4, Length 5
 (6) Were any formations sealed against pollution?
 _____ yes, no.

If YES depth of formation _____

Why _____

Drillers Remarks: Well located at W.W. Martin home on Hwy 11 Next to his Service Sta

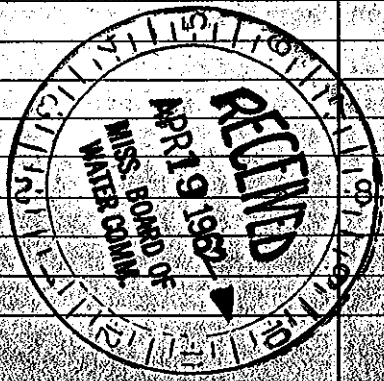

(Use Back Side)

Well No _____