

JASPER MISSISSIPPI BOARD OF WATER COMMISSIONERS

WATER WELL DRILLERS LOG


Date: Oct 29, 1962, Driller: Porter Drilling & Supply Co. Jasper, Wayne County, Mississippi

| (1) Owner of Land: | Description & Color of Materials Sand, Clay, Red Clay, Shell, etc. | Thick- ness Feet | Depth Feet |
|---|---|------------------------|---------------|
| <u>Harold Welch</u> (Name) | <u>red clay</u> | <u>20</u> | <u>20</u> |
| <u>Vosberg Miss.</u> (Address) | <u>shale</u> | <u>52</u> | <u>72</u> |
| <u>1 N 13 E</u> | <u>fine sand</u> | <u>10</u> | <u>82</u> |
| (2) Location: <u>1/4</u> , <u>1/4</u> , Sec. <u>14</u> T. <u>R.</u> | <u>med. sand</u> | <u>7</u> | <u>89</u> |
| <u>3/4</u> miles <u>east</u> , of <u>Vosberg</u> | <u>stratified on streaks of shale</u> | | |
| (3) Topography: <u>hilly</u> | | | |
| (4) Purpose of Well: <u>domestic</u> | | | |

Information upon completion of well:

- (1) Diameter 2" inches.
- (2) Total Depth 89' feet.
- (3) Water Level 20 feet below top of ground.
- (4) Cased to 84', Size 2"
- (5) Screen: Size 1 1/4", Length 5'
Johnson slanting steel
- (6) Were any formations sealed against pollution?
no

If YES depth of formation _____
Why _____
Drillers Remarks: _____

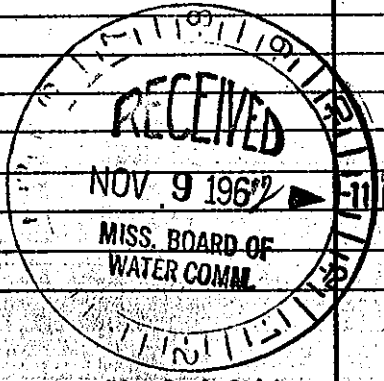

Well No. _____

Mail this copy to Board of Water Commissioners 429 Miss. St. Jackson, Miss.