

JASPER MISSISSIPPI BOARD OF WATER COMMISSIONERS

3 Q 17


11-18-65 WATER WELL DRILLERS LOG

Date: Nov. 18, 1965, Driller: Porter Drilling & Pump Co. Jasper
(Name)

(1) Owner of Land: <u>Willet Bunch</u> <small>(Name)</small>	Description & Color of Materials Sand, Clay, Red Clay, Shell, etc.	Thick- ness Feet	Depth Feet
<u>Qt 2 Vocabery</u> <small>(Address)</small>	<u>red sand</u>	<u>14</u>	<u>14</u>
(2) Location: <u>NW 1/4, NE 1/4, Sec. 13 T. 1 R. 13</u>	<u>red chalk fine sand</u>	<u>11</u>	<u>25</u>
<u>4</u> miles <u>N</u> of <u>Stallons</u> <small>(distance) (direction) (Nearest Town)</small>	<u>blue chalk</u>	<u>247</u>	<u>272</u>
(3) Topography: <u>hilly</u> <small>(Hilly) (Flat) (Level)</small>	<u>soft lime rock & streaks of sand</u>	<u>28</u>	<u>300</u>
(4) Purpose of Well: <u>domestic</u> <small>(Domestic Irrigation Municipal, Industrial, Other)</small>	<u>stiff blue chalk</u>	<u>36</u>	<u>336</u>
	<u>sand & lignite</u>	<u>3</u>	<u>339</u>
	<u>lime rock</u>	<u>1</u>	<u>340</u>
	<u>sand, lignite & chalk mixed with</u>		
	<u>last 20' being</u>		
	<u>mostly clear sand</u>	<u>101</u>	<u>441</u>
	<u>stopped while still</u>		
	<u>in sand</u>		

Information upon completion of well:

- (1) Diameter 2" inches.
 - (2) Total Depth 441 feet.
 - (3) Water Level 150' feet below top of ground.
 - (4) Cased to 357, Size 2"
 - (5) Screen: Size 1 1/4, Length 18'
 - (6) Were any formations sealed against pollution?
 yes, no.
- If YES depth of formation 25'
- Why Cut off shallow strata
- Drillers Remarks: 30' 4" cas

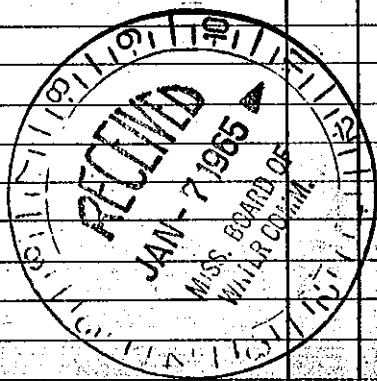

(Use Back Side)

Well No.