

Q21

CODED

WATER WELL DRILLERS LOG

1-21-62

Date: Jan 21, 1962, Driller: U. N. Porterson County: Jasper
(Name)

(1) Owner of Land:	Description & Color of Materials Sand, Clay, Red Clay, Shell, etc.	Thick-ness Feet	Depth Feet
<u>Mrs. Touchstone</u> <small>(Name)</small>	<u>red clay sandy</u>	<u>30</u>	<u>30</u>
<u>Vasberg, Miss</u> <small>(Address)</small>	<u>fine sand</u>	<u>30</u>	<u>60</u>
(2) Location: <u>1/4, 23 NW 13C</u> , Sec. <u>T R</u>	<u>medium sand</u>	<u>13</u>	<u>73</u>
<u>_____</u> miles <u>of Vasberg</u> , <small>(distance) (direction) (Nearest Town)</small>	<u>per gravel with chack</u>	<u>8</u>	<u>81</u>
(3) Topography: <u>Hilly</u> <small>(Hilly) (Flat) (Level)</small>			
(4) Purpose of Well: <u>domestic</u> <small>(Domestic Irrigation Municipal, Industrial, Other)</small>			

CODED


Information upon completion of well:

- (1) Diameter 2' inches.
- (2) Total Depth 73 feet.
- (3) Water Level 60 feet below top of ground.
- (4) Cased to 69', Size 2"
- (5) Screen: Size 1 1/4', Length 4'
Johnson S.S
- (6) Were any formations sealed against pollution?
 _____ yes, no.

If YES depth of formation _____

Why _____

Drillers Remarks: _____

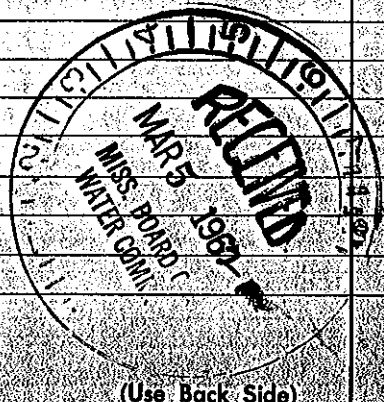

Well No. _____

(Use Back Side)

Mail this copy to Board of Water Commissioners 429 Miss. St. Jackson, Miss