

**JASPER**  
**Q 35**  
**11-19-74**

MISSISSIPPI  
 BOARD OF WATER COMMISSIONERS  
 416 North State Street  
 Jackson, Mississippi 39201

**CODED**

**WATER WELL DRILLERS LOG**

Nov 19 1974 *Roey Westwater wells Jasper*  
 date well completed firm name county well located


LANDOWNER	description of formations encountered	from	to
<i>Leno Lightsey</i>	<i> sandy clay</i>	<i>0</i>	<i>16</i>
<i>General Delaney Box 3</i>	<i>clay</i>	<i>16</i>	<i>90</i>
<i>Wosburg</i>	<i>sandy clay</i>	<i>90</i>	<i>108</i>
(mailing address)	<i>Blue Clay</i>	<i>108</i>	<i>400</i>
	<i>sand</i>	<i>400</i>	<i>430</i>

WELL LOCATION  
 sec 21 T 1 R 13  
 miles 5 of Wosburg  
 (distance) (direction) (nearest town)

WELL PURPOSE: Home  
 (home, irrigation, municipal, industrial)

- WELL COMPLETION DATA:
- (1) diameter (inches) 2 in
  - (2) total depth (feet) 430
  - (3) static water level (feet) 150 <sup>below</sup>/<sub>above</sub> top of ground.
  - (4) casing Galv 420  
 (material) (depth)  
 (size) if telescope see back.
  - (5) screen 10 ft 420  
 (length) (depth to top)  
1/2 st steel  
 (size) (material)
  - (6) pump 1/2 5  
 (HP) (yield gpm)  
R&A  
 (type power)
  - (7) electric log NO  
 (yes or no)
  - (8) how well bottom plugged wash value

**CODED**

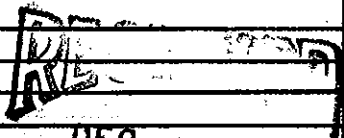

DEC 5 1974

MISS. BD. OF WATER COMM

DRILLERS REMARKS: