

JASPER
R 3
11-19-60

MISSISSIPPI BOARD OF WATER COMMISSIONERS

WATER WELL DRILLERS LOG

R 301

Date: 11-19, 1960, Driller: W. K. Barnes County Jasper
(Name)

(1) Owner of Land: Paul Johnson
(Name)
Stringer Miss.
(Address)

Description & Color of Materials Sand, Clay, Red Clay, Shell, etc.	Thick- ness Feet	Depth Feet
<u>Red Clay</u>	<u>6</u>	<u>30</u>
<u>Sand</u>	<u>30</u>	<u>75</u>

(2) Location: 1/4, 1/4, Sec. 2, T. 10R, R. 10E
_____ miles _____ of Stringer
(distance) (direction) (Nearest Town)

(3) Topography: Level
(Hilly) (Flat) (Level)

(4) Purpose of Well: Home use
(Domestic Irrigation
Municipal, Industrial, Other)


Information upon completion of well:

- (1) Diameter 2 inches.
- (2) Total Depth 75 feet.
- (3) Water Level 40 feet below top of ground.
- (4) Cased to 69, Size 2.
- (5) Screen: Size 80, Length 4.
- (6) Were any formations sealed against pollution?
_____ yes, _____ no.

If YES depth of formation _____

Why _____

Drillers Remarks: _____

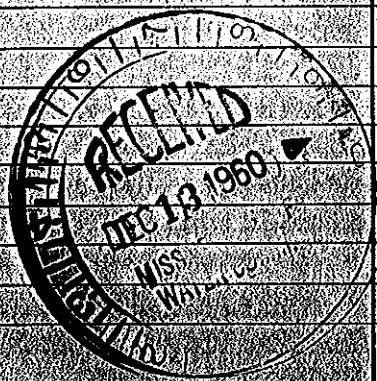

(Use Back Side)

Well No