

3 130 314810 N 0891895 TMCA

Jasper  
R14  
9-68

MISSISSIPPI  
BOARD OF WATER COMMISSIONERS  
416 North State Street  
Jackson, Mississippi 39201

WATER WELL DRILLERS LOG

CODED


7-24 1968 W.K. Barnes Water Wells Jasper  
date well completed firm name county well located

LANDOWNER: <u>W.D. Buckley</u>	description of formations encountered	from	to
<u>Route 1</u>			
<u>Soso Miss.</u>	<u>yellow clay</u>	<u>8</u>	<u>51</u>
(mailing address)	<u>Water Sand</u>	<u>51</u>	<u>70</u>

WELL LOCATION:  
sec 28 T 10 N R 13 E  
5 miles South of Stringer  
(distance) (direction) (nearest town)

WELL PURPOSE: Home use  
(home, irrigation, municipal, industrial)

- WELL COMPLETION DATA:
- (1) diameter (inches) 2
  - (2) total depth (feet) 70
  - (3) static water level (feet) 45 below above top of ground.
  - (4) casing Galv. (material) (depth)
  - 1 1/2" (size) If telescope see back.
  - (5) screen 5' (length) (depth to top)
  - 8 Blat. Stainless Steel (size) (material)
  - (6) pump 1 (HP) 12 (yield gpm)
  - Elec (type power)
  - (7) electric log NO (yes or no)
  - (organization running log)
  - (8) how well bottom plugged Wash Valve

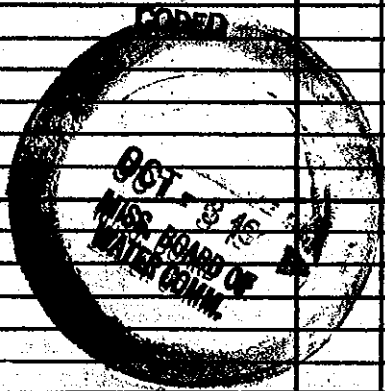

DRILLERS REMARKS: