

3 130

314845N 6891950

TMCA

Gasper  
R15  
9-25-68

MISSISSIPPI  
BOARD OF WATER COMMISSIONERS  
416 North State Street  
Jackson, Mississippi 39201

WATER WELL DRILLERS LOG

CODED

7-25 date well completed  
W. K. Barnes water well firm name  
Gasper county well located

LANDOWNER: Dannie Warren  
Rt. 1  
Stringer miss 394891  
(mailing address)


description of formations encountered	from	to
Red clay	0	10
yellow clay	10	25
Fine Sand	25	36
yellow clay	36	52
Water Sand	52	74

WELL LOCATION:  
sec. 21 T. 10 N. R. 13 E.  
4 miles Swest of Stringer  
(distance) (direction) (nearest town)

WELL PURPOSE: Home use  
(home, irrigation, municipal, industrial)

- WELL COMPLETION DATA:
- (1) diameter (inches) 2
  - (2) total depth (feet) 74
  - (3) static water level (feet) 42 below above top of ground.
  - (4) casing Galv. 69  
(material) (depth)  
1 1/2 if telescope see back.  
(size)
  - (5) screen 51  
(length) (depth to top)  
1/2 slot Stainless Steel  
(size) (material)
  - (6) pump 1/2 5  
(HP) (yield gpm)  
Electric  
(type power)
  - (7) electric log no  
(yes or no)  
(organization running log)
  - (8) how well bottom plugged Wash Valve

CODED

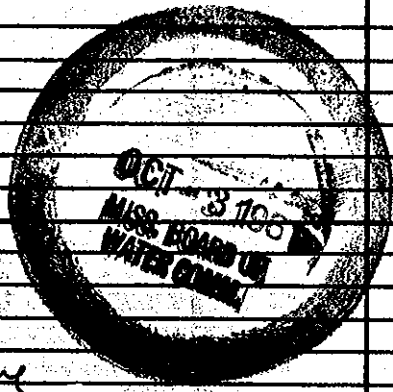

DRILLERS REMARKS: