State Well Fart 1 Part 1 Part 1 Part 1 Mississippi Department of Environmental Quality Office of Land and Water Resources P.O. Box 10631 Jackson, MS 39289-0631 (601)961-5210 (601)354-6938 (fax)  State Law requires that this report be prepared by the driller in detail and filed with the Department within  State Law requires that this report be prepared by the driller in detail and filed with the Department within  Well Owner Information  Downer Name Denbury Onshore  Mailing Address PO. Box 506 Laure MS  City State Zip Code  Telephone No. Well Circle one) Home Industrial Public Supply Irrigation Fish Culture Other Fig Supply  Well Data  Purpose of Well (circle one) Home Industrial Public Supply Irrigation Fish Culture Other Fig Supply  If flowing, method of flow regulation: Valve Other (describe)  State Well Fig Supply Irrigation Fish Culture Other Fig Supply  If flowing, method of flow regulation: Valve Other (describe)  State Well filling of the well drilling completed: 4 - 28 - 06  Method of Measurenent (circle one) steel tape electric tape air line other:  Hole depth: 103 Well depth: 100 Well grouted to a depth of 10 feet
Mississippi Department of Environmental Quanty Office of Land and Water Resources P.O. Box 10631 Jackson, MS 39289-0631 (601)961-5210 (601)354-6938 (fax)  State Law requires that this report be prepared by the driller in detail and filed with the Department within 30 days of completion of drilling of the well.  Well Owner Information Owner Name Denbury Onshere Mailing Address:  Method of LavLong (circle one): Conventional Survey.  Well Data  Well Data  Well Data  Purpose of Well (circle one) Home Industrial Public Supply Irrigation Fish Culture  Date well drilling started:  Y 27-06  Date well drilling completed:  USGS quad, Hand-held GPS, Survey-grade GPS  Well Data  Purpose of Well (circle one) Home Industrial Public Supply Irrigation Fish Culture Other: Fig. Supply  Telephone No.  USGS quad, Hand-held GPS, Survey-grade GPS  Direction of Second Miles Well drilling completed:  Y 28-06  Static Water Level:  Get above of below (circle one) land surface Date measured:  Method of Measurer, ent (circle one) steel tape electric tape air line other:
Office of Land at the P.O. Box 10631  P.O. Box 10631  Jackson, MS 39289-0631  (601)961-5210  (601)354-6938 (fax)  State Law requires that this report be prepared by the driller in detail and filed with the Department within 30 days of completion of drilling of the well.  Well Owner Information  Dwner Name  Denbury  Onshere  Mailing Address:  City  State  State  Zip Code  Well Data  Purpose of Well (circle one) Home  Industrial  Public Supply  Irrigation  Fish Culture  Other:  Tig Supply  Trigation  Fish Culture  Other:  Tig Supply  Trigation  Tig Supply  Trigation  Tig Supply  Trigation  Tig Supply  The State Water Level:  Static Water Level:  Get above of below (circle one) land surface  Other:  Method of Measurement (circle one)  Steel tape  electric tape  air line  Other:  Other:  Method of Measurement (circle one)  Steel tape  electric tape  air line  Other:  Method of Measurement (circle one)  Steel tape  electric tape  air line  Other:  Method of Measurement (circle one)  Steel tape  electric tape  air line  Other:  Method of Measurement (circle one)  Steel tape  electric tape  air line  Other:  Method of Measurement (circle one)  Steel tape  Steel tape  Other:  Method of Measurement (circle one)  Steel tape  electric tape  air line  Other:  Method of Measurement (circle one)  Steel tape  Steel tape  Steel tape  Steel tape  Other:  Method of Measurement (circle one)  Steel tape  St
P.O. Box 10031  Jackson, MS 39289-0631  (601)961-5210 (601)354-6938 (fax)  State Law requires that this report be prepared by the driller in detail and filed with the Department within 30 days of completion of drilling of the well.  Well Owner Information  Denor Name Denor Y Orshore  Mailing Address: PO. Box 506 Laure MS  City State Zip Code  Telephone No. ()  Well Data  Purpose of Well (circle one) Home Industrial Public Supply Irrigation Fish Culture Other Fig. 544-06  If flowing, method of flow regulation: Valve Other (describe)  Static Water Level: 60 feet above or below (circle one) land surface fair line other: 11 fair line other:
Jackson, MS 39289-0631  (601)961-5210  (601)354-6938 (fax)  State Law requires that this report be prepared by the driller in detail and filed with the Department within 30 days of completion of drilling of the well.  Well Owner Information  Well
State Law requires that this report be prepared by the driller in detail and filed with the Department within  State Law requires that this report be prepared by the driller in detail and filed with the Department within  Well Owner Information  Owner Name Denbury Onshore  Mailing Address: PO. Box 506 Laure MS  Method of Lavlong (circle one). Conventional Survey.  USGS quad. Hand-held GPS, Survey-grade GPS  Well Data  Purpose of Well (circle one) Home Industrial Public Supply Irrigation Fish Culture Other rig supply  Date well drilling started: 4-27-06  Date well drilling completed: 4-28-06  If flowing, method of flow regulation: Valve Other (describe)  Static Water Level: 60 feet above or below (circle one) land surface Date measured: 4-28-06  Method of Measuren.ent (circle one) steel tape electric tape air line other:
State Law requires that this report be prepared by the driller in detail and filed with the Department within  State Law requires that this report be prepared by the driller in detail and filed with the Department within  Well Owner Information  Well Owner Information  Well Owner Information  Distance  City  State  Zip Code  Well Data  Purpose of Well (circle one) Home  Industrial  Public Supply Irrigation  Public Supply Irrigation  Fish Culture  Other Fig Supply  Date well drilling completed: 4-28-06  If flowing, method of flow regulation: Valve  Other (describe)  Static Water Level: 60 feet above on below (circle one) land surface  Method of Measuren.ent (circle one) steel tape electric tape  air line  other:
State Law requires that this report be prepared by the driller in detail and filed with the Department within 30 days of completion of drilling of the well.  Well Owner Information  Well Owner Information  Department Willing Address: PO. Box 506 Laurel MS  Well Owner Name Department on Survey.  Method of Lav/Long (circle one): Conventional Survey.  USGS quad, Hand-held GPS, Survey-grade GPS  Well Data  Purpose of Well (circle one) Home Industrial Public Supply Irrigation Fish Culture Other Fig. Surply  Date well drilling started: 4-27-06  Date well drilling completed: 4-28-06  If flowing, method of flow regulation: Valve Other (describe)  Static Water Level: 60 feet above or below (circle one) land surface Date measured: 4-28-06  Method of Measurement (circle one) steel tape electric tape other:
Well Owner Information Owner Name Denbury Onshore  Mailing Address: PO. Box 506 Laure MS  City State Zip Code  Well Data  Well Data  Purpose of Well (circle one) Home Industrial Public Supply Irrigation Fish Culture Other: Fig Supply  Bate well drilling started: 4-27-06 Date well drilling completed: 4-28-06  If flowing, method of flow regulation: Valve Other (describe)  Static Water Level: 60 feet above on below (circle one) land surface Date measured: 4-28-06  Method of Measurement (circle one) steel tape electric tape air line other:
Well Owner Information  Latitude:
Well Owner Information  where Name Denbury Onshore  Method of Lat/Long (circle one): Conventional Survey.  USGS quad, Hand-held GPS, Survey-grade GPS  Well Data  Well Data  Purpose of Well (circle one) Home Industrial Public Supply Irrigation Fish Culture Other: Fig Supply  Bate well drilling started: 4-27-06 Date well drilling completed: 4-28-06  Static Water Level: 60 feet above or below (circle one) land surface Date measured: 4-28-06  Method of Measurer ent (circle one) steel tape electric tape air line other:
Well Owner Information  Well Owner Information  Well Owner Information  Method of Lat/Long (circle one): Conventional Survey.  Well Odd (circle one): Conventional Survey.  USGS quad, Hand-held GPS, Survey-grade GPS  Well Data  Well Data  Purpose of Well (circle one) Home Industrial Public Supply Irrigation Fish Culture Other: Fig Supply  Date well drilling started: 4-27-06 Date well drilling completed: 4-28-06  Static Water Level: 60 feet above on below (circle one) land surface Date measured: 4-28-06  Method of Measurement (circle one) steel tape electric tape air line other:
Method of Lat/Long (circle one): Conventional Survey.  Method of Lat/Long (circle one): Conventional Survey.  USGS quad, Hand-held GPS, Survey-grade GPS  USGS quad, Hand-held GPS, Survey-grade GPS  Well Data  Purpose of Well (circle one) Home Industrial Public Supply Irrigation Fish Culture Other: Fig. Supply  Date well drilling started: 4-27-06  Date well drilling completed: 4-28-06  Static Water Level: 60 feet above or below (circle one) land surface Date measured: 4-28-06  Method of Measurer ent (circle one) steel tape electric tape air line other:
Method of Lat/Long (circle one): Conventional Survey.  Method of Lat/Long (circle one): Conventional Survey.  USGS quad, Hand-held GPS, Survey-grade GPS  USGS quad, Hand-held GPS, Survey-grade GPS  Well Data  Purpose of Well (circle one) Home Industrial Public Supply Irrigation Fish Culture Other: Fig. Supply  Date well drilling started: 4-27-06  Date well drilling completed: 4-28-06  Static Water Level: 60 feet above or below (circle one) land surface Date measured: 4-28-06  Method of Measurer ent (circle one) steel tape electric tape air line other:
Atailing Address: PO. Box 506 Laure   Method of Date well drilling started: 4-28-06  Static Water Level: 60 feet above or below (circle one) steel tape electric tape  Well Data  Well Data  Well Data  Well Data  Well Data  Well Data  Public Supply Irrigation Fish Culture Other: Fig. Supply  Date well drilling completed: 4-28-06  Static Water Level: 60 feet above or below (circle one) land surface Date measured: 4-28-06  Method of Measurement (circle one) steel tape electric tape air line other: 100 feet above or below (circle one) land surface Date measured: 100 feet air line other: 100 feet above or below (circle one) land surface Date measured: 100 feet air line other: 100 feet air line
USGS quad, Hand-held GPS, Survey-grade GPS    Well Data
City State Zip Code    Value
City State Zip Code    Value
City State Zip Code  Distance Miles Direction of Second Miles No. (
City State Zip Code  Distance Miles Direction of Sero  Well Data  Purpose of Well (circle one) Home Industrial Public Supply Irrigation Fish Culture Other: Fig Supply  Bate well drilling started: 4-27-06 Date well drilling completed: 4-28-06  If flowing, method of flow regulation: Valve Other (describe)  Static Water Level: 60 feet above of below (circle one) land surface Date measured: 4-28-06  Method of Measurement (circle one) steel tape electric tape air line other:
Purpose of Well (circle one) Home Industrial Public Supply Irrigation Fish Culture Other: rig supply  Bate well drilling started: 4-27-06 Date well drilling completed: 4-28-06  If flowing, method of flow regulation: Valve Other (describe)  Static Water Level: 60 feet above on below (circle one) land surface Date measured: 4-28-06  Method of Measurement (circle one) steel tape electric tape air line other:
Purpose of Well (circle one) Home Industrial Public Supply Irrigation Fish Culture Other: rig supply  Bate well drilling started: 4-27-06 Date well drilling completed: 4-28-06  If flowing, method of flow regulation: Valve Other (describe)  Static Water Level: 60 feet above on below (circle one) land surface Date measured: 4-28-06  Method of Measurement (circle one) steel tape electric tape air line other:
Purpose of Well (circle one) Home Industrial Public Supply Irrigation Fish Culture Other: <u>rig supply</u> Date well drilling started: <u>4-27-06</u> Date well drilling completed: <u>4-28-06</u> If flowing, method of flow regulation: Valve Other (describe)  Static Water Level: <u>60</u> feet above or below (circle one) land surface Date measured: <u>4-28-06</u> Method of Measurement (circle one) steel tape electric tape air line other:
Purpose of Well (circle one) Home Industrial Public Supply Irrigation Fish Culture Other: Fig. 34ply  Bate well drilling started: 4-27-06 Date well drilling completed: 4-28-06  If flowing, method of flow regulation: Valve Other (describe)  Static Water Level: 60 feet above or below (circle one) land surface Date measured: 4-28-06  Method of Measurement (circle one) steel tape electric tape air line other:
Purpose of Well (circle one) Home Industrial Public Supply Irrigation Fish Culture Other: <u>rig supply</u> Date well drilling started: <u>4-27-06</u> Date well drilling completed: <u>4-28-06</u> If flowing, method of flow regulation: Valve Other (describe)  Static Water Level: <u>60</u> feet above on below (circle one) land surface Date measured: <u>4-28-06</u> Method of Measurement (circle one) steel tape electric tape air line other:
Purpose of Well (circle one) Home industrial  Date well drilling started: 4-28-06  If flowing, method of flow regulation: Valve Other (describe)  Static Water Level: 60 feet above on below (circle one) land surface Date measured: 4-28-06  Method of Measurement (circle one) steel tape electric tape air line other:
Purpose of Well (circle one) Home Industrial  Date well drilling started: 4-28-06  If flowing, method of flow regulation: Valve Other (describe)  Static Water Level: 60 feet above on below (circle one) land surface Date measured: 4-28-06  Method of Measurement (circle one) steel tape electric tape air line other:
Date well drilling started: 4-27-06 Date well drilling completed.  If flowing, method of flow regulation: Valve Other (describe)  Static Water Level: 60 feet above on below (circle one) land surface Date measured: 4-28-06  Method of Measurement (circle one) steel tape electric tape air line other:
Static Water Level: 60 feet above or below (circle one) land surface Date measured: 4-8-06  Method of Measurement (circle one) steel tape electric tape air line other:
Static Water Level: 60 feet above or below (circle one) land surface Date measured: 4-8-06  Method of Measurement (circle one) steel tape electric tape air line other:
Static Water Level: 60 feet above or below (circle one) land surface Date measured.  Method of Measurement (circle one) steel tape electric tape air line other:
Method of Measurement (circle one) steel tape electric tape air line
Method of Measurement (circle one) steel tape electric tape air line
Method of Measurement (circle one)
Well depth: 100 Well grouted to a depth of 10 feet
Well depth: 100 Well depth:
Hole depth:
Type of grout (circle one): Cement Demonts
Casing length: 80 feet Casing diameter: 4 inches Type of casing:
Casing length: 80 feet Casing diameter: 1 inches Type of screen: PVC S/of feet Screen diameter: 4 inches Type of screen:
inches Type of screen: // US/17/1-
Screen length: 20 feet Screen diameter: 4 inches Type of Screen. 7
Screen length:
Type of completion (circle all applicable): Gravel packed Underreamed
Other (describe):
describe on back of Dag
Top of lap pipe or reduction in casing:feet. If telescoped or more than one screen, describe on back of page
Top of tap pipe of foldering in the second of the second o
Logs run (circle all applicable) No log run Electric Gamma Ray Density Sonic Neutron Other:
Name of organization running log(s):  I certify that the well was drilled, constructed, and completed in accordance with all applicable requirements of the Mississ
I contify that the well was drilled, constructed, and completed in accordance with all applicable requirements of the walls

Department of Environmental Quality and/or the Mississippi Department of Health regulations and state laws.

Print Name of Water Well Contractor and License No.

**RECEIVED** 

Signature of Water Well Contractor

JUN 0 1 2006

BY: OLWR


If well telescopes please sketch below and show depths

Ground	Level
0.040	

Description of Formations Encountered	From	То
Sand.	0	20
sand	10	40
sand + clax	40	60
sand	60	1
sand	80	103
		+
		+
		-
		<del></del>
		+
	_ <del></del>	
		+

Timore than one screen, show location of each on sketch

Sketch the property layout and include the following: 1) the well location; 2) any permanent structures on the property that may aid in locating the well; 3) any roads, power lines, or other items that may aid in locating the property and the well; 4) indicate direction.

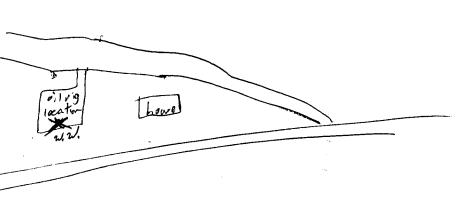

Landowner Name:

## STATE WELL REPORT

Part 2

Pump Installer's Completion Report Mississippi Department of Environmental Quality Office of Land and Water Resources P.O. Box 10631 Jackson, MS 39289-0631 (601)961-5210 (601)354-6938 (fax)

For Office Use Only:	
Aquifer	
Well #: 2 -40	
Elevation:	

Date completed 4ed by the pump installer in detail and filed with the Department within 30 days of the

Permit A

This report should be prepared by the pump installer in detail	And thee with the
- II-dian of DUMD	Well Location
installation of pump.  Well Owner Information	
	Latitude:Longitude:
Owner Name: <u>Penbury</u> Onshore	Latitude
Owner Name: Pen var 7	Method of Lat/Long (circle one): Conventional Survey.
Mailing Address: 10. Box 506 Laurel MS	Method of Day 2018 (
Mailing Address.	-USGS quad, Hand-held GPS, Survey-grade GPS
	1/4 1/4 Sec_ 28 Twm_ 101 Rng_ 132/
	1/4 Sec Twn Rng /S 40
City State Zip Code	Distance Direction Nearest Town
	H Miles NW of Soso
	Miles _ 10 W of _ 303 0
Telephone No. ()	
	Power Type
	Circle one
Pump Type	
Circle one	Diesel Engine Gasoline Engine Natural Gas
Submersible Submersible	Dieser Bug.
Air Lift Jet Submersion	Hand Tractor PTO
Piston Turbine	PETECHTIC INITION
Bucket	Windmill Other (specify).
Committee Rotary Flowing Well	Winding
Centrifugal	Horse Power Rating of Motor:
Other (specify):	Moise to the second sec
11 7 V - 1/4	Setting Depth: 80 feet
Other (specify): 4-28-06	
3.5 Gallons Per Minute	Number of Stages:
Rated Pump Capacity: 35 Gallons Per Minute	
	Method of Measuring Water Level
Pump Test Data	Circle one
Date Well Tested: 4-28-06	Air Line Electric Measuring Line Steel Tape
Date well 100000	All Bills
Static Water Level (A): 60 Feet Below Land Surface	Other (specify):
1 Delaw Land Surface	
Pumping Water Level (B):Feet Below Land Surface	in the band feet
Drawdown [(B) - (A)] Feet Below Land Surface	For flowing well, measured shut in headfeet
Drawdown [(B) - (A)]	Well yielded 40 GPM with a drawdown of
Test Pumping Rate Gallons Per Minute	
Test Pumping Rate	feet afterhours of pumping
hours of Pump Test (minimum 4 hours):	icci anci
Duration of Pump Test (minimum 4 hours): hours	
	was my knowledge /
I HEREBY CERTIFY that the above statements are true to the be	St Of the Michigan
	Will Trade
John W. Thompson U-6/	Signature of Pump Installer
Print Name of Pump Installer and License No. (if applicable)	
•	V

RECEIVED JUN 0 1 2006 BY: OLWR