

DEP

MISSISSIPPI DEPARTMENT OF ENVIRONMENTAL QUALITY
Office of Land and Water Resources

P. O. Box 10631
Jackson, MS 39289-0631
WATER WELL DRILLERS LOG

COUNTY, WELL LOCATED	Jasper
WELL NUMBER	R 2017
CODED	
DATE WELL COMPLETED	9-7-95

PERMIT NUMBER	
NAME OF DRILLING FIRM	A-1 Drilling Serv. Inc.
	Louis, Ms. 39440

NAME & MAILING ADDRESS OF LANDOWNER			
Joey Sumrall			
Rt. 1 Box 321 D			
Stringer, Ms. 39481			
WELL LOCATION	SEC	TOWNSHIP	RANGE
SE NW	9	10 S	13 E
DISTANCE	DIRECTION	NEAREST TOWN	
3 Miles	W	of Stringer	
OTHER LANDMARK			
Just east of Stone's Store			
WELL PURPOSE: Home, Irrigation, Municipal, Industrial, Fish Pond, etc.			
Chicken Houses			

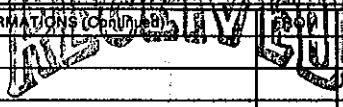
PUMP DATA		
PUMP TYPE (Circle One):		
<input checked="" type="radio"/> Submersible	Turbine	Jet
Other (Describe) _____		
POWER TYPE (Circle One):		
<input checked="" type="radio"/> Electric	Tractor	Diesel
Gasoline	Butane	
Other (Describe) _____		
Pump Capacity (GPM)	No. of Stages	Setting Depth
20	11	120' FT.
PUMP TEST		
Well yielded _____ GPM with		
a drawdown of _____ ft.		
after _____ hours of pumping		

WELL DATA		
Well Depth	Casing Diameter (In.)	Casing Length (Ft.)
150'	4"	140'
Type of Casing	Hole Depth	Depth to Static Water Level
PVC	154'	68'
TYPE OF COMPLETION: (Circle One or More):		
<input checked="" type="checkbox"/> Gravel Packed	<input type="checkbox"/> Underreamed	<input type="checkbox"/> Telescoped
<input checked="" type="checkbox"/> Natural Development	<input type="checkbox"/> Open Hole	<input type="checkbox"/> Other
(Describe) _____		
WELL GROUTED TO A DEPTH OF 12 FEET		
Type Grout (circle one): Cement, Bentonite, or Mix		

LOG DATA	
TYPE OF LOG RUN (Circle One):	
<input type="checkbox"/> Electric	<input checked="" type="checkbox"/> No Log Run
<input type="checkbox"/> Gamma Ray	<input type="checkbox"/> Density
<input type="checkbox"/> Sonic	<input type="checkbox"/> Neutron
Other (Describe) _____	
Name of Organization Running Log	

SCREEN DATA		
Diameter - Inches	Length - Feet	Slot Size - Inches
4"	10'	.006
Screen Type	Depth to Bottom - Feet	
Slotted PVC	150'	

GEOLOGIC DATA (Office Use Only)			
Surface Elev.	Geologic Unit	Unit Thickness	Depth to Top
Subs. SWL	Date	Analysis	Aquifer Test
Driller's Remarks			

DESCRIPTION OF FORMATIONS ENCOUNTERED	FROM	TO	FORMATIONS (Continued)	TO
Red clay	0	12	 DEC 05 1995 Dept. of Environmental Quality Office of Land & Water Resources	
Sand (Red)	12	41		
White + Pink clay	41	50		
clay w/ sand	50	67		
Sand + pea gravel	67	140		
pea gravel + sand	140	151		
clay + sand streaks	151	154		

IF MORE SPACE IS NEEDED, USE BACK