

JASPER, MISSISSIPPI BOARD OF WATER COMMISSIONERS

S. 6

WATER WELL DRILLERS LOG

Date: 11-22-65, 1965, Driller: G.P. Clark County Jasper

(1) Owner of Land: Dr Donaldson
 (Name)
 Rt #1 Moss Miss
 (Address) 10 N 12 W

(2) Location: 1/4, 1/4, Sec. 2 T. R.
 1/2 miles North of Moss
 (distance) (direction) (Nearest Town)

(3) Topography: (Hilly) (Flat) (Level)

(4) Purpose of Well: Chicken Farm
 (Domestic Irrigation
 Municipal, Industrial, Other)


Description & Color of Materials Sand, Clay, Red Clay, Shell, etc.	Thick- ness Feet	Depth Feet
0-35 Clay	35	
35-86 Sand	51	
86-200 Clay	114	
200-215 Sand	15	
215-340 Clay	131	
340-410 Sandy Clay	70	
410-424 Sand	14	

Information upon completion of well:

- (1) Diameter 2 inches.
- (2) Total Depth 424 feet.
- (3) Water Level 60 feet below top of ground.
- (4) Cased to 414, Size 2
- (5) Screen: Size 1 1/4, Length 10
- (6) Were any formations sealed against pollution?
 yes, no.

If YES depth of formation 328
 Why Seal top water off

Drillers Remarks:

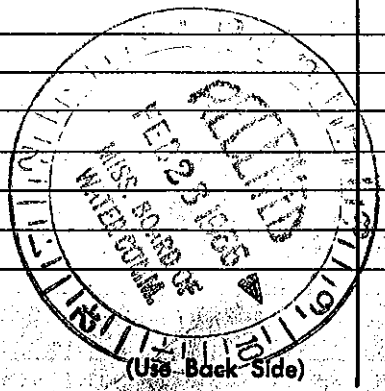

Well No

Mail this copy to Board of Water Commissioners 429 Miss. St. Jackson, Miss.