

JASPER MISSISSIPPI BOARD OF WATER COMMISSIONERS

WATER WELL DRILLERS LOG

Date: Sept 3, 1965, Driller: Porter Drilling & Log County: Jasper
(Name)


(1) Owner of Land: Walker Truck Stop
(Name)
11 Heidelberg, Miss
(Address)
 (2) Location: NE 1/4, NW 1/4, Sec. 21 10N 10W
T. R.
 _____ miles _____ of _____
(distance) (direction) (Nearest Town)
 (3) Topography: flat
(Hilly) (Flat) (Level)
 (4) Purpose of Well: domestic
(Domestic Irrigation, Municipal, Industrial, Other)

Description & Color of Materials Sand, Clay, Red Clay, Shell, etc.	Thick- ness Feet	Depth Feet
red clay	8	8
red sand	9	17
blue chalk	22	39
thin rock		39
blue chalk	31	70
hard rock	2	72
blue chalk	11	83
honeycom rock	14	97
white Chalk to 2		
thin layer honeycom	15	112
stop for white		
chalk		

Information upon completion of well:

(1) Diameter 2" inches.
 (2) Total Depth 112' feet.
 (3) Water Level 8' feet below top of ground.
 (4) Cased to 84', Size 2"
 (5) Screen: Size _____, Length _____
none
 (6) Were any formations sealed against pollution?
 _____ yes, _____ no.

If YES depth of formation _____
 Why _____
 Drillers Remarks: _____

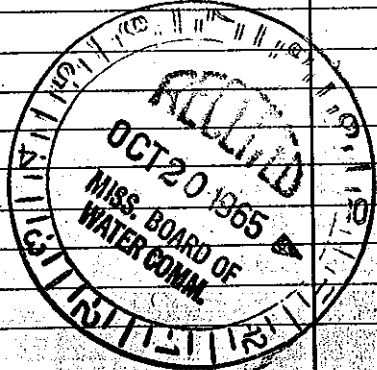

(Use Back Side)

Well No.