


JASPER MISSISSIPPI BOARD OF WATER COMMISSIONERS

U4 WATER WELL DRILLERS LOG

6-17-64

Date: June 17, 1964, Driller: Porter Drilling & Log County Jasper
(Name)

(1) Owner of Land:	Description & Color of Materials Sand, Clay, Red Clay, Shell, etc.	Thick- ness Feet	Depth Feet
<u>Walker Truck Stop</u> (Name)	<u>red clay</u>	10	10
<u>At 1 Heidelberg, Miss</u> (Address)	<u>soupy sand & clay</u>	10	20
(2) Location: <u>Lot 2</u> 1/4, Sec. <u>21</u> T. <u>10</u> R. <u>10</u>	<u>red sand</u>	6	26
<u>4</u> miles <u>north</u> of <u>Standville</u> (distance) (direction) (Nearest Town)	<u>blue chalk</u>	19	45
(3) Topography: <u>flat</u> (Hilly) (Flat) (Level)	<u>thin rock</u>		45
(4) Purpose of Well: <u>domestic</u> (Domestic Irrigation Municipal, Industrial, Other)	<u>brown chalk</u>	23	68
Information upon completion of well:	<u>sea shells</u>	4	72
(1) Diameter: <u>2"</u> inches.	<u>hard rock</u>	2	74
(2) Total Depth: <u>165'</u> feet.	<u>blue chalk</u>	10	84
(3) Water Level: <u>6'</u> feet below top of ground.	<u>hard rock with some honeycombed</u>	16	100
(4) Cased to: <u>88'</u> , Size <u>2"</u>	<u>white chalk</u>	38	138
(5) Screen: Size _____, Length _____	<u>thin rock</u>		138
(6) Were any formations sealed against pollution? yes, <input checked="" type="checkbox"/> no.	<u>fine sand & streaks of chalk</u>	27	165
If YES depth of formation _____	<u>blue chalk</u>	5	170
Why _____			
Drillers Remarks: _____			

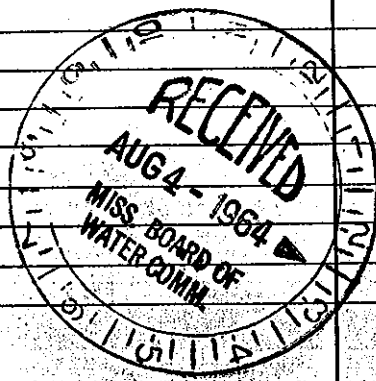

(Use Back Side)

Well No.

this copy to Board of Water Commissioners 429 Miss. St. Jackson, Miss.