

JASPER MISSISSIPPI BOARD OF WATER COMMISSIONERS

WATER WELL DRILLERS LOG

Date: 9/25, 1961, Driller: O.P. Clark County Jasper

(1) Owner of Land: Ben Hayles
Colored
Rt #1 Heidelberg Miss
 (Address)

(2) Location: 1/4, 1/4, Sec. 15 T. 10N R. 10W
4 miles South of Heidelberg
 (distance) (direction) (Nearest Town)

(3) Topography: (Hilly) (Flat) (Level)

(4) Purpose of Well: Domestic
 (Domestic Irrigation, Municipal, Industrial, Other)


Description & Color of Materials Sand, Clay, Red Clay, Shell, etc.	Thick- ness Feet	Depth Feet
<u>0-25 Red Clay</u>	<u>25</u>	<u>25</u>
<u>25-35 Yellow Sand Clay</u>	<u>10</u>	<u>35</u>
<u>35-530 Blue Clay</u>		
<u>Rock + Shell from 495</u>		<u>530</u>
<u>530-570 Sand</u>		
<u>fine Blue</u>	<u>40</u>	<u>570</u>

Information upon completion of well:

- (1) Diameter 2 inches.
- (2) Total Depth 570 feet.
- (3) Water Level 160 feet below top of ground.
- (4) Cased to 552, Size 2
- (5) Screen: Size 1 1/4, Length 18
- (6) Were any formations sealed against pollution?
 yes, no.

If YES depth of formation _____

Why _____
 Driller's Remarks: Well located
1 Mile South of
Beaver Meadow
Colored Church

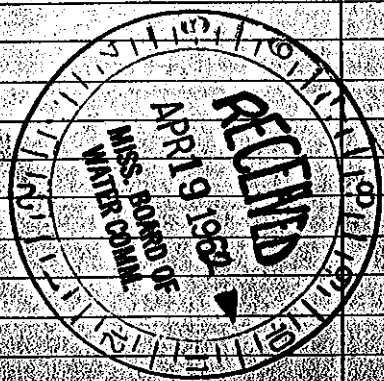

(Use Back Side)

Well No