

JASPER MISSISSIPPI BOARD OF WATER COMMISSIONERS

U9

10-15-63 WATER WELL DRILLERS LOG

Date: 10/15, 1963, Driller: O.P. Clark County Jasper


(1) Owner of Land:	Description & Color of Materials Sand, Clay, Red Clay, Shell, etc.	Thick- ness Feet	Depth Feet
Oscar Stanger (Name)	0-15 Yellow Sandy Clay	15	
Rt #2 Heidelberg Miss (Address)	15-35 Blue Clay	20	
10N 10W	35-90 Mottled Clay	45	
(2) Location: 1/4, 1/4, Sec. 12 T. R.	90-430 Clay + rock	360	
3 miles SE of Heidelberg (distance) (direction) (Nearest Town)	430-450 fine Sand + shells	20	
(3) Topography:	450-500 Clay	50	
(4) Purpose of Well: Domestic (Domestic Irrigation Municipal, Industrial, Other)	500-532 fine Sand	32	

Information upon completion of well:

- (1) Diameter 2 inches.
- (2) Total Depth 532 feet.
- (3) Water Level 152 feet below top of ground.
- (4) Cased to 500, Size 2 in
- (5) Screen: Size 1/4, Length 32
- (6) Were any formations sealed against pollution?
 yes, no.

If YES depth of formation 480
Why Seal Chalk

Drillers Remarks:

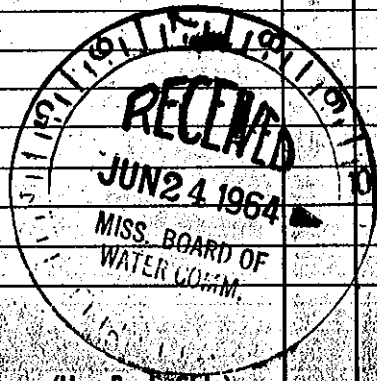

(Use Back Side)

Well No.

Mail this copy to Board of Water Commissioners 429 Miss. St. Jackson, Miss.