

JASPER MISSISSIPPI BOARD OF WATER COMMISSIONERS

WATER WELL DRILLERS LOG

12-15-62

Date: 12/15, 1962

Driller: C.P. Clark

County: Jasper

(Name)

(1) Owner of Land: Humbler Oil

Box #2 Heidelberg Miss

(2) Location: 1/4, 1/4, Sec 23 T10R10

5 1/2 miles NE of Sanderville

(3) Topography: Flat

(4) Purpose of Well: Municipal, Industrial, Other

Description & Color of Materials
Sand, Clay, Red Clay, Shell, etc.

Thick-
ness
Feet

Depth
Feet

0-15 Gray Clay 15
15-120 Blue clay 115
120-440 Blue Clay 320
440-484 sand 44

Information upon completion of well:

(1) Diameter 2 inches.

(2) Total Depth 484 feet.

(3) Water Level 85 feet below top of ground.

(4) Cased to 462, Size 2 in


(5) Screen: Size 1/4, Length 22

(6) Were any formations sealed against pollution?
yes, no

If YES depth of formation

Why

Drillers Remarks:

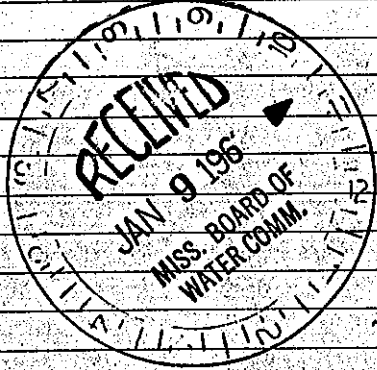

Well No

(Use Back Side)