

JASPER MISSISSIPPI BOARD OF WATER COMMISSIONERS


U 1/2
12-8-62

WATER WELL DRILLERS LOG

Jasper

Date: 12/8, 1962, Driller: C. P. Clark County Jasper
(Bryant Pumping Unit)

(1) Owner of Land:	Description & Color of Materials Sand, Clay, Red Clay, Shell, etc.	Thick- ness Feet	Depth Feet
Humble Oil (Name) Herdellburg Rt # 2 (Address)	0-55 Yellow Clay sand	55	
(2) Location: 1/4, 1/4, Sec. 23 T10R10W	55-90 Blue Clay	35	
5 1/2 miles N-E, Sandersville (distance) (direction) (Nearest Town)	90-140 Blue Clay shales	50	
(3) Topography: <input checked="" type="checkbox"/> (Hilly) <input type="checkbox"/> (Flat) <input type="checkbox"/> (Level)	140-460 Blue Clay	320	
(4) Purpose of Well: <input type="checkbox"/> (Domestic Irrigation) <input type="checkbox"/> (Municipal) <input type="checkbox"/> (Industrial) <input type="checkbox"/> (Other)	460-520 Clay shales	60	
	520-550 Blue Clay	30	
	550-560 Sand	10	
	560-634 Sand	57	
	+ Clay streaks		
	517-534 Sand	17	

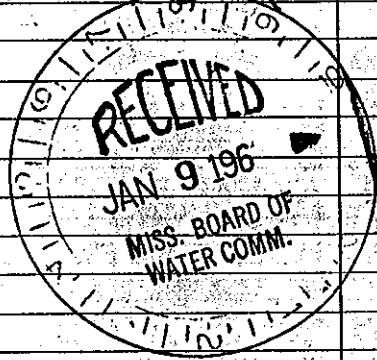

Information upon completion of well:

(1) Diameter 2 1/2 inches.

(2) Total Depth 634 feet.

(3) Water Level 160 feet below top of ground.

(4) Cased to 614, Size 2 1/2.

(5) Screen: Size 2 in, Length 20.

(6) Were any formations sealed against pollution?
 _____ yes, no.

If YES depth of formation _____

Why _____

Drillers Remarks: _____

Well No

(Use Back Side)