

JASPER MISSISSIPPI BOARD OF WATER COMMISSIONERS

U 13
12-12-62 WATER WELL DRILLERS LOG Jasper


Date 12/12/62 Driller: O.P. Clark County Jasper
(L. Mc Gill Tank Battery) (Name)

(1) Owner of Land: Humble Oil
(Name)
Heidelhog Miss
(Address)
(2) Location: 1/4, 1/4, Sec. 14 10N 70W T. R.
6 miles NE of Soudersville
(distance) (direction) (Nearest Town)
(3) Topography: Hilly
(Hilly) (Flat) (Level)
(4) Purpose of Well:
(Domestic Irrigation, Municipal, Industrial, Other)

Description & Color of Materials Sand, Clay, Red Clay, Shell, etc.	Thick- ness Feet	Depth Feet
0-20 Grey Clay	20	
20-40 Blue Clay	20	
40-140 Blue Clay & Shells	100	
140-450 Blue Clay	310	
450-510 Clay & Shells	60	
510-524 Sand	14	
524-560 Clay & Shells	36	
560-592 Sand	32	

Information upon completion of well:

(1) Diameter 2 inches.
(2) Total Depth 592 feet.
(3) Water Level 126 feet below top of ground.
(4) Cased to 568, Size 2 in.
(5) Screen: Size 1/4, Length 24.
(6) Were any formations sealed against pollution?
yes, no.

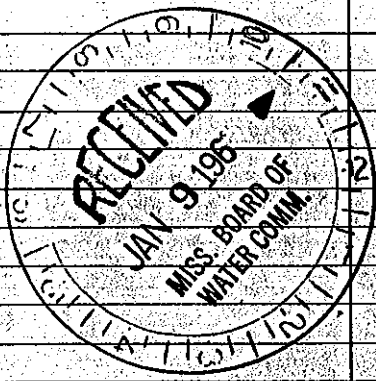

If YES depth of formation: _____
Why: _____
Drillers Remarks: _____

Well No

(Use Back Side)