

**JASPER MISSISSIPPI BOARD OF WATER COMMISSIONERS**

U 14  
12-10-63

**WATER WELL DRILLERS LOG**

Date: 12/10, 1963, Driller: C. P. Clark County Jasper Jones


(1) Owner of Land: Calvin M. Donald  
Rt # 2 Heidelberg Miss  
(Address) 10 N 1000  
(2) Location: 1/4, 1/4, Sec. 11 T. R.  
5 miles NE of Sandersville  
(distance) (direction) (Nearest Town)  
(3) Topography: Hilly  
(Hilly) (Flat) (Level)  
(4) Purpose of Well: Domestic  
(Domestic Irrigation  
Municipal, Industrial, Other)

Description & Color of Materials Sand, Clay, Red Clay, Shell, etc.	Thick- ness Feet	Depth Feet
0-16 red sandy clay	16	
16-70 clay	54	
70-120 Rock & Chalk	50	
120-220 soft clay	100	
220-480 clay	260	
480-518 blue sand	38	

**Information upon completion of well:**

(1) Diameter 2 inches.  
(2) Total Depth 518 feet.  
(3) Water Level 100 feet below top of ground.  
(4) Cased to 498, Size 2 in.  
(5) Screen: Size 1 1/4, Length 20  
(6) Were any formations sealed against pollution?  
yes, no.

If YES depth of formation  
Why  
Drillers Remarks:

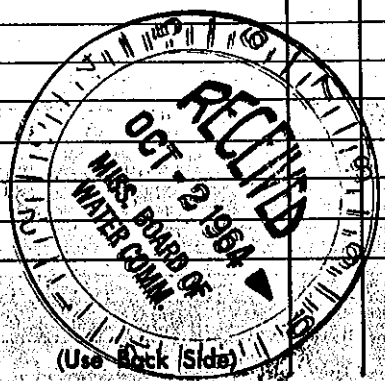

Well No.

Mail this copy to Board of Water Commissioners 429 Miss. St. Jackson, Miss