

well #2

STATE WELL REPORT

Part 1

Driller's Log

Mississippi Department of Environmental Quality
 Office of Land and Water Resources
 P.O. Box 2309
 Jackson, MS 39225-2309
 (601)961-5555
 (601)961-5228 (fax)

For Office Use Only:

Well #: 1156
 Aquifer: _____
 E-Log #: _____

County: Jasper
 Permit #: _____
 Driller: Dave West
 Date drilling completed: 8-10-2018

State Law requires that this report be prepared by the license holder responsible for the work and filed with the Department at the above address within 30 days of completion of drilling of the well or borehole.

Well Owner Information (Landowner if borehole is not for a water well)	Well or Borehole Location
Owner Name: <u>Christopher Burton</u>	Latitude: <u>31-50-51</u> Longitude: <u>88-59-15</u>
Mailing Address: <u>412 Hwy 11N</u>	Method of Lat/Long (check one): Conventional Survey _____ USGS quad <u>X</u> , Hand-held GPS _____, Survey-grade GPS _____
<u>Heidelberg</u> MS <u>39439</u> City State Zip Code	<u>SW</u> 1/4 <u>NE</u> 1/4, Sec <u>10</u> T. <u>10N</u> R. <u>10W</u>
Telephone No. (601) <u>498-9583</u>	<u>4</u> Miles <u>N</u> of <u>Sandersville</u> (Distance) (Direction) (Nearest Town)

Well / Borehole Data

Date drilling started: 8-8-2018 Date drilling completed: 8-10-2018 Hole depth: 560' Hole diameter: 6 1/2"

Location of the source of any surface water used for drilling: Well water

Method of dosing and volume of Chlorine used in drilling and development: Tabs 50lb/m

Logs run (check all applicable): Log run Electric Gamma Ray Density Sonic Neutron Other: _____

Name of organization running log(s): _____

Purpose of borehole (check one): Water Well Geotechnical/Geological Investigation Ground Source Heat Pump Seismic Survey Other (describe) _____

If drilling is not related to water well construction, skip the remainder of this block

Purpose of Well (check all applicable): Home Industrial Public Supply Irrigation Fish Culture
 Other (describe): Poultry Farm

If a flowing well, method of flow regulation: Valve _____ Other (describe) _____

Static Water Level: 195 feet above or below land surface Date measured: 8-10-2018
 (check one)

Method of measurement (check one) Steel tape Electric tape Air line Other (describe): Sonic

Well depth: 560 Well grouted to a depth of: 50 feet Type of grout (check one) Neat Cement Bentonite Mix

Casing length: 500 feet Casing diameter: 4 inches Type of casing: PVC

Screen length: 50 feet Screen diameter: 2 inches Type of screen: PVC

Screen slot size: .008 inches Setting depth: From 510 feet to RECEIVED feet

Type of completion (check all applicable) gravel packed Underreamed Open hole Natural Development

Other (describe): _____

Top of lap pipe or reduction in casing: 410 feet

BY OLWR

AUG 23 2018

If telescoped or more than one screen, describe on next page

Well #2


County: Jasper
 Permit #: _____

For Office Use Only:
 Well #: 1156

The sketch below only required for water wells

Description of formations encountered must be provided for all wells and boreholes, unless specifically exempted by regulations


If well telescopes, show depths on sketch.

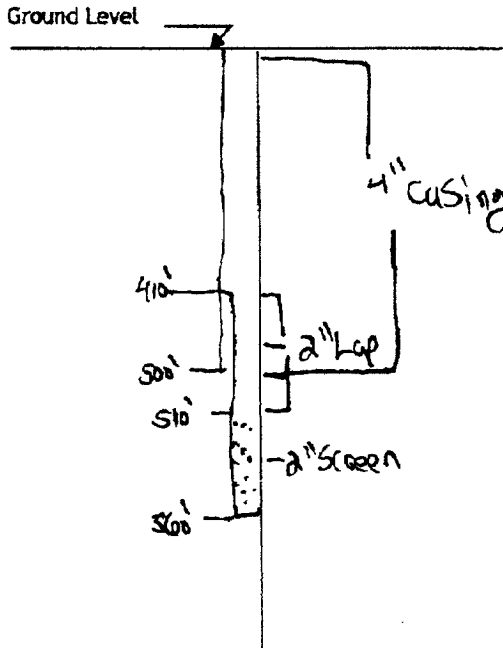

Description of Formations Encountered	From (depth)	To (depth)
Sand	Ground level	22
Clay	22	80
Rock w/ clay streaks	80	130
sandy	130	142
Clay	142	350
Mudv's	350	380
Clay	380	393
Sand/clay	393	460
Sand-fine	460	510
Sand-coarse/clean	510	560

If more than one screen, show location of each on sketch

- Sketch the property layout and include the following:
- 1) the well location
 - 2) any permanent structures on the property that may aid in locating the well
 - 3) any roads, power lines, or other items that may aid in locating the property and the well
 - 4) north arrow

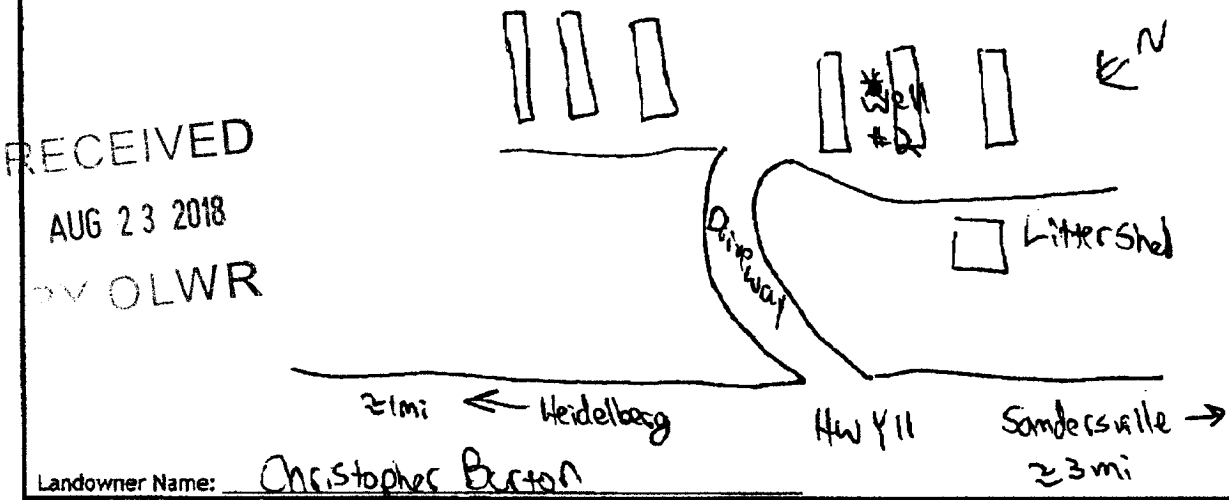

RECEIVED
 AUG 23 2018
 BY OLWR

Landowner Name: Christopher Burton

I HEREBY CERTIFY that the well/borehole was drilled, constructed, and completed in accordance with all applicable requirements of the Mississippi Department of Environmental Quality and the Mississippi Department of Health regulations, if applicable, and state laws.

Dave West 002 8-15-2018 [Signature]
 Print Name of Responsible Licensee and License No. Date Signature of Licensee

Well #

STATE WELL REPORT

Part 2

Pump Installer's Completion Report
 Mississippi Department of Environmental Quality
 Office of Land and Water Resources
 P.O. Box 2309
 Jackson, MS 39225-2309
 (601)961-5210
 (601) 360-0535 (fax)

For Office Use Only:

Well #: 1156
 Aquifer: _____

County: Sage
 Permit #: _____
 Driller: Dave West
 Date completed: 8-10-2018
Copy information from block on Part 1

This part of the report must be completed by a licensed water well contractor or a licensed pump installer. A copy of Part 1 of the report must be attached and both parts filed with the Department at the above address within 30 days of well completion.

Well Owner Information	Well Location
Owner Name: <u>Christopher Burton</u>	Latitude: <u>31-50-51</u> Longitude: <u>88-59-15</u>
Mailing Address: <u>412 HWY 11N</u>	Method of Lat/Long (check one): Conventional Survey _____, USGS quad <u>X</u> , Hand-held GPS _____, Survey-grade GPS _____
<u>Heidelberg</u> MS <u>39439</u>	<u>SW 1/4 NE 1/4, Sec 10 T 10N R 10W</u>
City State Zip Code	<u>4</u> Miles <u>N</u> of <u>Sandersville</u>
Telephone No. <u>(601) 498-9583</u>	(Distance) (Direction) (Nearest Town)

Pump Type (check one)
 Submersible Turbine Air Lift Centrifugal Flowing Well Jet Piston Rotary Other (describe): _____
 Date Pump Installed: 8-11-2018 Rated Pump Capacity: 45 Gallons Per Minute
 Is This Pump (check one): New Repaired Replacement

Power Type (check one)
 Electric Diesel Gasoline Natural Gas Tractor PTO Windmill Other (describe): _____
 Horse Power Rating of Motor: 5HP Setting Depth: 315 feet Number of Stages: _____

Pump Test Data for Non Flowing Well
 Date Well Tested: _____ Duration of Pump Test (minimum 4 hours): _____ hours
 Static Water Level (A): _____ Feet Below Land Surface Pumping Water Level (B): _____ Feet Below Land Surface
 Drawdown [(B) - (A)]: _____ Feet Below Land Surface Test Pumping Rate: _____ Gallons Per Minute
 Method of measurement (check one): Steel tape Electric tape Air line Other (describe): _____

Pump Test Data for Flowing Well
 Measured shut in head: _____ feet.
 Well yielded _____ GPM with a drawdown of _____ feet after _____ hours of pumping

Meter Installation
 Meter Manufacturer: _____ Meter Serial Number: _____
 Meter Model Number/Name: _____ Type of Meter: _____
 Totalizer Register Unit and Multiplier Factor (AF x .001, gal x 1000, etc): _____
 Installation Date: _____ Meter installed by: _____
 Is This Meter (check one): New Repaired Replacement
Important: By submitting the above information you are certifying that this meter was installed to manufacturer standards. For agricultural wells, a list of approved meters is on the MDEQ website.

RECEIVED
 AUG 23 2018
 BY OLWR

I HEREBY CERTIFY that the above statements are true to the best of my knowledge.
Dave West 0672 Date _____ Signature of Pump Installer
 Print Name of Pump Installer and License No. (if applicable)