


A-84

If well telescopes please sketch and show depths.

GROUND LEVEL

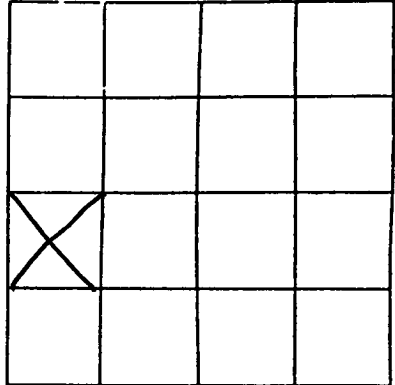

SECTION 13

Please indicate well location X.

| | | | |
|---------------------|---------------|---------------|-----|
| Pump Capacity (GPM) | No. of Stages | Setting Depth | |
| 60 | 14 | 80 | FT. |

PUMP TEST

Well yielded _____ GPM with
 a drawdown of _____ ft.
 after _____ hours of pumping

LOG DATA

TYPE OF LOG RUN (Circle One): No Log Run
 Electric, Gamma Ray, Density, Sonic, Neutron,
 Other (Describe) _____

Name of Organization Running Log

GEOLOGIC DATA (Office Use Only)

| | | | |
|---------------|---------------|----------------|--------------|
| Surface Elev. | Geologic Unit | Unit Thickness | Depth to Top |
| Subs. SWL | Date | Analysis | Aquifer Test |

Driller's Remarks

If more than one screen, show location of each on sketch.