

Jeff Davis MISSISSIPPI BOARD OF WATER COMMISSIONERS
 B114
 4-27-65
 WATER WELL DRILLERS LOG
 CODED CODED CODED CODED CODED CODED CODED CODED CODED CODED

Date: 4-27, 1965, Driller: Jay Gath County: Jeff Davis
 Henry Rutane Dues


(1) Owner of Land: M. Nalon Bridges
 (Name)
 New Hebron, Miss.
 (Address)
 (2) Location: 1/4, 1/4, Sec. 7 T. 9 N. R. 18
 18 miles N, of Prentiss
 (distance) (direction) (Nearest Town)
 (3) Topography: Hilly
 (Hilly) (Flat) (Level)
 (4) Purpose of Well: Domestic
 (Domestic Irrigation
 Municipal, Industrial, Other)

Description & Color of Materials Sand, Clay, Red Clay, Shell, etc.	Thick- ness Feet	Depth Feet
0-15 Bc		
15-23 Lc		
23-30 Gs		
30-62 Wc		
62-83 Ws		

Information upon completion of well:

(1) Diameter: 2" inches.
 (2) Total Depth: 83 feet.
 (3) Water Level: 29 feet below top of ground.
 (4) Cased to _____, Size _____
 (5) Screen: Size 2", Length 10 ft.
 (6) Were any formations sealed against pollution?
 _____ yes, _____ no.
 If YES depth of formation _____
 Why _____
 Drillers Remarks: _____

CODED

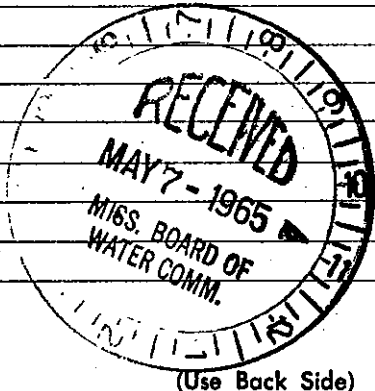

Well No.