

1

County: Jeff Davis
Permit #: 0-586
Driller: JAMES WELLS
Date drilling completed: 1-24-12

State Well Report
Part 1 - Driller's Log
Mississippi Department of Environmental Quality
Office of Land and Water Resources
P.O. Box 2309
Jackson, MS 39225
(601)961- 5210
(601)961- 5228 (fax)

For Office Use Only:
Aquifer: B 51
Well #: _____
L. S. Elevation: _____
E-log #: _____

State Law requires that this report be prepared by the license holder responsible for the work and filed with the Department at the above address within 30 days of completion of drilling of the well or borehole.

<p>Information on Well Owner (Landowner if borehole is not for a water well)</p> <p>Owner Name: <u>Jay Bass</u> Mailing Address: <u>32 Cornerstone Rd</u> <u>Prentiss MS</u> <u>39474</u> City: <u>601</u> State: <u>MS</u> Zip Code: <u>39474</u> Telephone No.: <u>540 1894</u></p>	<p>Well or Borehole Location</p> <p>Latitude: <u>31.44.26.4</u> Longitude: <u>89.49.38.2</u></p> <p>Method of Lat/Long (circle one): Conventional Survey, USGS quad, Hand-held GPS, Survey-grade GPS</p> <p><u>NE</u> 1/4 Sec <u>30</u> Twn <u>18N</u> Rng <u>9W</u> <u>NW</u> 1/4 Sec <u>9N</u> 18W</p> <p>Distance <u>1</u> Miles <u>NE</u> Direction of <u>Prentiss MS</u> Nearest Town</p>
----------------------------------------------------------------------------------------------------------------------------------------------------------------------------------------------------------------------------------------------------------------------------------------------------------------------	---------------------------------------------------------------------------------------------------------------------------------------------------------------------------------------------------------------------------------------------------------------------------------------------------------------------------------------------------------------------------------------------------------------

Well / Borehole Data

Date drilling started: 1-24-12 Date drilling completed: 1-24-12 Hole depth: 225 Hole diameter: 7

Location of the source of any surface water used for drilling: creek

Method of dosing and volume of Chlorine used in drilling and development: sheet 3 lb

Logs run (circle all applicable): No log run Electric Gamma Ray Density Sonic Neutron Other: _____

Name of organization running log(s): _____

Purpose of borehole (check one): Water Well Geotechnical/Geological Investigation Ground Source Heat Pump
Seismic Survey Other (describe) _____

If drilling is not related to water well construction, skip the remainder of this block

Purpose of Well (check one): Home Industrial Public Supply Irrigation Fish Culture Other: _____

If a flowing well, method of flow regulation: Valve _____ Other (describe) _____

Static Water Level: 120 feet above or below (circle one) land surface Date measured: 1-24-12

Method of Measurement (circle one) steel tape electric tape air line other: _____

Well depth: 225 Well grouted to a depth of 10 feet Type of grout (circle one): Neat Cement Bentonite Mix

Casing length: 185 feet Casing diameter: 4 inches Type of casing: PVC

Screen length: 40 feet Screen diameter: 4 inches Type of screen: PVC

Screen slot size: .008 inches Setting depth: From 185 feet to 225 feet

Type of completion (circle all applicable): Gravel packed Underreamed Telescoped Open hole Natural Development
Other (describe): _____

Top of lap pipe or reduction in casing: _____ feet. *If telescoped or more than one screen, describe on next page*

Form: OLWR-SWR-1A (04/08)

RECEIVED
FEB 27 2012
BY: OLWR

B 51


If well telescopes please sketch below and show depths.

Ground Level _____

Description of Formations Encountered	From	To
Clay	0	40
Sand	40	70
Clay	70	130
Per. gravel	130	160
Gravel	160	225

If more than one screen, show location of each on sketch

Sketch the property layout and include the following: 1) the well location; 2) any permanent structures on the property that may aid in locating the well; 3) any roads, power lines, or other items that may aid in locating the property and the well; 4) indicate direction.

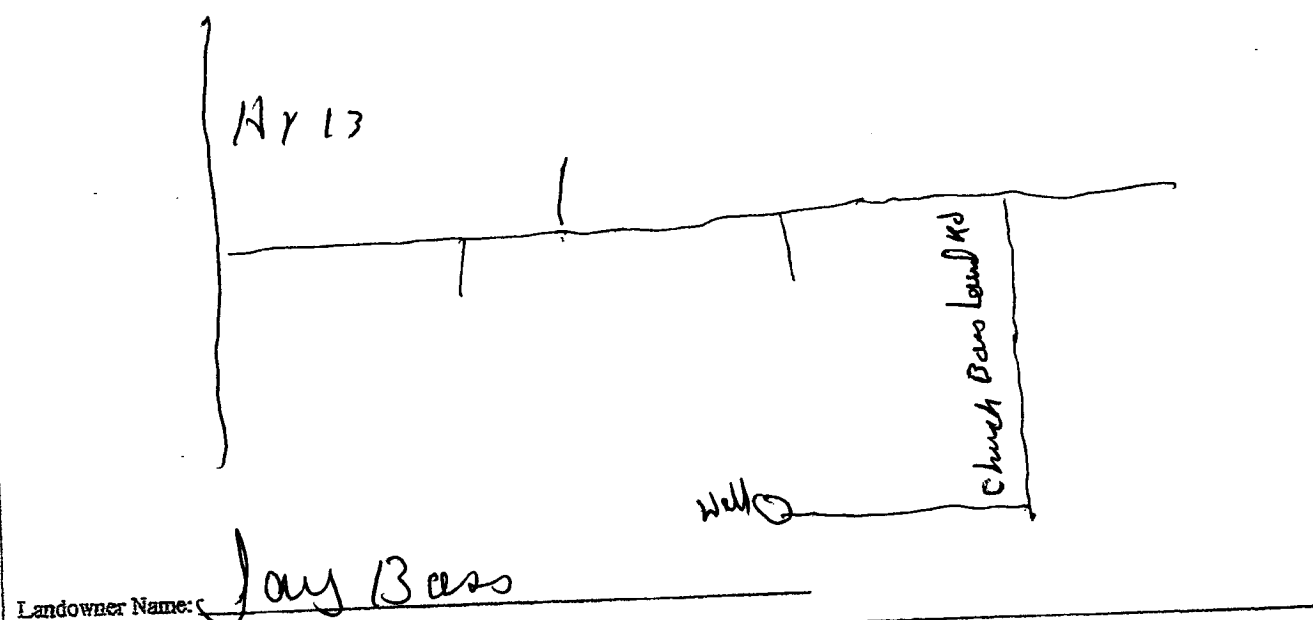

James Wells
 Signature of Water Well Contractor

RECEIVED
 FEB 27 2012
 BY: OLWR

1

Jeff Davis

STATE WELL REPORT

Part 2

Pump Installer's Completion Report
Mississippi Department of Environmental Quality
Office of Land and Water Resources
P.O. Box 10631
Jackson, MS 39289-0631
(601)961-5210
(601)354-6938 (fax)

For Office Use Only:

Aquifer: _____

Well #: BS1

Elevation: _____

County: _____

Permit #: _____

Driller: JAMES WELLS

Date completed: 1-24-12

This report should be prepared by the pump installer in detail and filed with the Department within 30 days of the installation of pump.

Well Owner Information		Well Location	
Owner Name: <u>Jay Bass</u>		Latitude: <u>31-44269</u>	Longitude: <u>894938W</u>
Mailing Address: <u>32 Cornstone Rd</u>		Method of Lat/Long (circle one): Conventional Survey,	
<u>Prentiss MS</u>		USGS quad, Hand-held GPS, Survey-grade GPS	
<u>39474</u>		<u>NW</u> 1/4 <u>NE</u> 1/4 Sec <u>20</u> Twn <u>18N</u> Rng <u>9W</u>	
City State Zip Code		<u>9N</u> <u>18W</u>	
Telephone No. (<u>601</u>) <u>540-1894</u>		Distance Direction Nearest Town	
		<u>2</u> Miles <u>NE</u> of <u>Prentiss</u>	

Pump Type Circle one			Power Type Circle one		
Air Lift	Jet	<u>Submersible</u>	Diesel Engine	Gasoline Engine	Natural Gas
Bucket	Piston	Turbine	<u>Electric Motor</u>	Hand	Tractor PTO
Centrifugal	Rotary	Flowing Well	Windmill	Other (specify): _____	
Other (specify): _____			Horse Power Rating of Motor: <u>5 HP</u>		
Date Pump Installed: <u>1-24-12</u>			Setting Depth: <u>180</u> feet		
Rated Pump Capacity: <u>50</u> Gallons Per Minute			Number of Stages: <u>13</u>		

Pump Test Data		Method of Measuring Water Level Circle one	
Date Well Tested: <u>1-24-12</u>		Air Line	Electric Measuring Line
Static Water Level (A): <u>120</u> Feet Below Land Surface		Other (specify): _____	Steel Tape
Pumping Water Level (B): <u>180</u> Feet Below Land Surface		For flowing well, measured shut in head: _____ feet	
Drawdown [(B) - (A)]: <u>160</u> Feet Below Land Surface		Well yielded <u>50</u> GPM with a drawdown of	
Test Pumping Rate: <u>50</u> Gallons Per Minute		<u>120</u> feet after <u>4</u> hours of pumping	
Duration of Pump Test (minimum 4 hours): <u>4</u> hours			

I HEREBY CERTIFY that the above statements are true to the best of my knowledge.

JAMES WELLS 0-586
Print Name of Pump Installer and License No. (if applicable)

James Wells
Signature of Pump Installer

RECEIVED
FEB 27 2012
BY: OLWR