

JEFF DAVIS  
 D 9  
 8-68

MISSISSIPPI  
 BOARD OF WATER COMMISSIONERS  
 416 North State Street  
 Jackson, Mississippi 39201

WATER WELL DRILLERS LOG

8-12-1968 PRENTISS BUTANE JEFF DAVIS  
 date well completed firm name county well located

LANDOWNER: CLARENCE HALL	description of formations encountered	from	to
PRENTISS, MISS			
(mailing address)	CHALK	0	20
	SAND	20	80


WELL LOCATION:  
 sec. 32 T 9 R 18 E  
 8 miles N.E. of PRENTISS  
 (distance) (direction) (nearest town)

WELL PURPOSE:  
 (home, irrigation, municipal, industrial)

WELL COMPLETION DATA:

- (1) diameter (inches) 2"
- (2) total depth (feet) 80
- (3) static water level (feet) 45 below top of ground
- (4) casing PLASTIC, 80 (material) (depth)  
 If telescope see back. (size)
- (5) screen 5, 75 (length) (depth to top)  
 2" PLASTIC (size) (material)
- (6) pump 3/4 (HP) (yield gpm)  
 ELECTRIC (type power)
- (7) electric log (yes or no)  
 (organization running log)
- (8) how well bottom plugged BWV

CODED

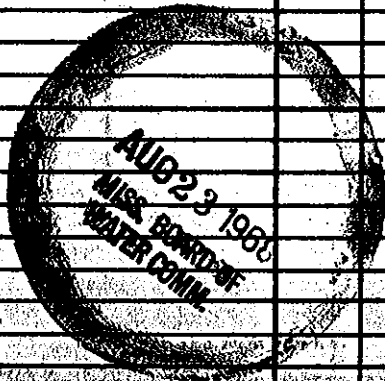

DRILLERS REMARKS: