

Jeff. Davis

MISSISSIPPI BOARD OF WATER COMMISSIONERS

E8

CODED

WATER WELL DRILLERS LOG

C (or) E

5-6-61

Date: 5-6, 1961, Driller: Jay Lott

(Name)

County Jeff Davis

(1) Owner of Land: John Myers (Name) Prentiss, Miss. (Address)

Description & Color of Materials Sand, Clay, Red Clay, Shell, etc.

Thick-ness Feet

Depth Feet

Red clay 10
white " 10-40
" sand 40-50
Red " 50-120
white " 120-140

(2) Location: 1/4, 1/4, Sec. 37 T 7R19, 3 miles SW of Prentiss (direction) (Nearest Town)

(3) Topography: Hilly (Hilly) (Flat) (Level)

(4) Purpose of Well: Domestic (Domestic Irrigation Municipal, Industrial, Other)

Information upon completion of well:

(1) Diameter 2 inches.

(2) Total Depth 140 feet.

(3) Water Level 55 feet below top of ground.

(4) Cased to bottom, Size 2 in.

(5) Screen: Size 2 in., Length 10 ft.

(6) Were any formations sealed against pollution?


yes, X no.

If YES depth of formation

Why

Drillers Remarks:

CODED

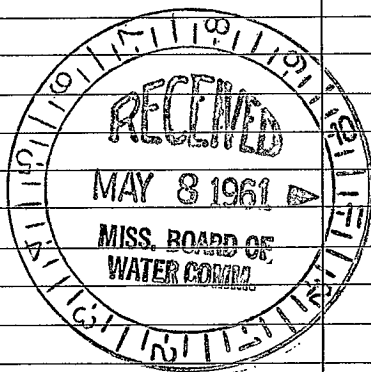

(Use Back Side)

Well No.