

Jefferson Davis  
E 13. CODED

MISSISSIPPI  
BOARD OF WATER COMMISSIONERS  
416 North State Street  
Jackson, Mississippi 39201

WATER WELL DRILLERS LOG

9-4-68

9-4-1968 PRENTISS BUTNEGAS JEFF DAVIS  
date well completed firm name county well located

LANDOWNER: JOSH TYRONE  
ROUTE 3  
PRENTISS MISS  
(mailing address)

description of formations encountered

from to

SAND	0	20
GRAVEL	20	50
SAND	50	70
GRAVEL	70	90

WELL LOCATION:  
sec. 28 T 7 N S R 19 E W  
1/2 miles S.W. of PRENTISS  
(distance) (direction) (nearest town)

WELL PURPOSE:  
(home, irrigation, municipal, industrial)


WELL COMPLETION DATA:

- (1) diameter (inches) 2
- (2) total depth (feet) 90
- (3) static water level (feet) 70 below above top of ground.
- (4) casing GALV 90 (material) (depth)  
(size) if telescope see back.
- (5) screen 3 87 (length) (depth to top)  
24 5.5 (size) (material)
- (6) pump 1 500 (HP) (yield gpm)  
ELECTRIC (type power)

(7) electric log (yes or no)  
(organization running log)


(8) how well bottom plugged B.W.V

DRILLERS REMARKS:

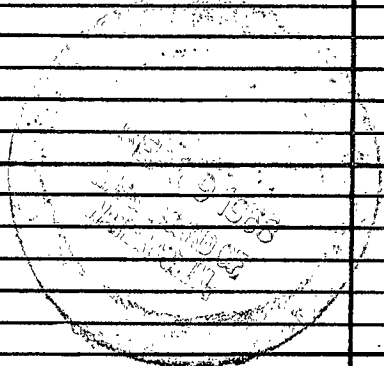

If well telescopes please sketch and show depths.

GROUND LEVEL

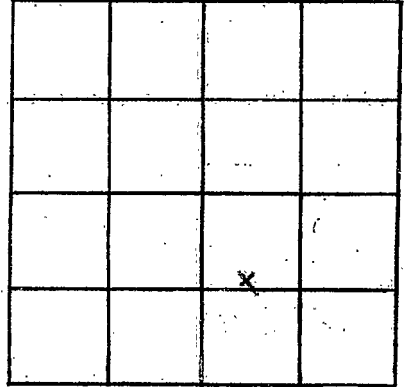

SECTION 28

Please indicate well location X.

ADDITIONAL INFORMATION

If more than one screen, show locations of each on sketch.