

Jeff Davis
E 14.
7-68

MISSISSIPPI
BOARD OF WATER COMMISSIONERS
416 North State Street
Jackson, Mississippi 39201

CODED WATER WELL DRILLERS LOG

7-22 1968 PRENTISS BUTANE JEFF DAVIS
date well completed firm name county well located

LANDOWNER: G. W. PRICE
PRENTISS MISS
(mailing address)

description of formations encountered	from	to
	SAND	0
CHALK	12	40
SAND	40	90

WELL LOCATION: NW SE
sec. 11 T 7 N R 19 E
S W
5 miles of PRENTISS
(distance) (direction) (nearest town)

WELL PURPOSE: INDUSTRIAL
(home, irrigation, municipal, industrial)

WELL COMPLETION DATA:

(1) diameter (inches) 4

(2) total depth (feet) 90

(3) static water level (feet) 40 below above top of ground.

(4) casing PLASTIC, 90
(material) (depth)
(size) If telescope see back.

(5) screen 5' 85'
(length) (depth to top)
4" PLASTIC
(size) (material)

(6) pump 1 1150 GPH
(HP) (yield gpm)
ELECTRIC
(type power)

(7) electric log (yes or no)
(organization running log)

(8) how well bottom plugged BWV


CODED

PRENTISS BUTANE
WATER COMPANY

DRILLERS REMARKS:

If well telescopes please sketch and show depths.

GROUND LEVEL

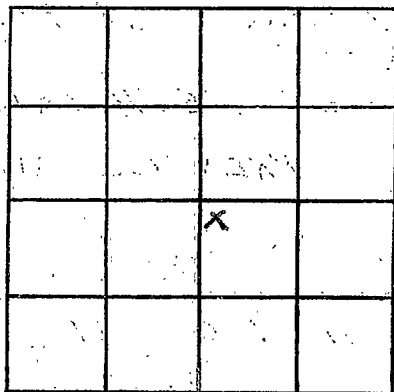

SECTION 11

Please indicate well location X.

ADDITIONAL INFORMATION

If more than one screen, show locations of each on sketch.