

C. P. CLARK
WATER WELL DRILLERS
 ROUTE 2
 MISSISSIPPI LAUREL, MISS. 39440

BOARD OF WATER COMMISSIONERS
 416 North State Street
 Jackson, Mississippi 39201

WATER WELL DRILLERS LOG

Jeff Davis
E 16
5-30-69
M.G.S.
5/30 19**69**

C.P. Clark **Jeff Davis**
 firm name county well located

LANDOWNER: *Town of Prentiss*
Prentiss Miss

WELL LOCATION: *N 49 S. W 9 S. W 1*
 sec. 1 T. 7 N. R. 19 E.
1 1/2 miles *South* of *Prentiss*
 (distance) (direction) (nearest town)

WELL PURPOSE: *Test Hole*
 (home, irrigation, municipal, industrial)

WELL COMPLETION DATA:

- (1) diameter (inches) 2
- (2) total depth (feet) 525
- (3) static water level (feet) 81 below above top of ground.
- (4) casing *galv. iron* (material) (depth) _____
 _____ if telescope see back.
 (size)
- (5) screen 10ft, 515
 (length) (depth to top)
2, S.S.
 (size) (material)
- (6) pump 2 8 1/2
 (HP) (yield gpm)
220V S.P.
 (type power)
- (7) electric log yes
 (yes or no)
Miss Leo Sawyer
 (organization running log)
- (8) how well bottom plugged B.W.U.

description of formations encountered	from	to
<i>Sandy Clay + Sand</i>	<i>0</i>	<i>85</i>
<i>Sand + Blue Gravel</i>	<i>85</i>	<i>105</i>
<i>Gravel 3/4" 1 1/2" + Sand C.</i>	<i>105</i>	<i>175</i>
<i>Sand + gravel streaks</i>	<i>175</i>	<i>204</i>
<i>Cavity lost Circulation</i>	<i>204</i>	<i>207</i>
<i>Sand + Gravel</i>	<i>207</i>	<i>225</i>
<i>Cavity lost Circulation</i>	<i>225</i>	<i>227</i>
<i>Coarse Sand</i>	<i>227</i>	<i>291</i>
<i>Sticky Clay + Sand</i>	<i>291</i>	<i>340</i>
<i>Clay</i>	<i>340</i>	<i>375</i>
<i>Sandy Clay</i>	<i>375</i>	<i>387</i>
<i>Clay</i>	<i>387</i>	<i>412</i>
<i>Clay + Sand streaks</i>	<i>412</i>	<i>487</i>
<i>Small fine to Medium</i>	<i>487</i>	<i>529</i>
<i>Clay - few shell streaks</i>	<i>529</i>	<i>670</i>
<i>Hard Clay (Sticky)</i>	<i>670</i>	<i>864</i>
<i>Clay w-shell streaks</i>	<i>864</i>	<i>897</i>
<i>Hard Clay</i>	<i>897</i>	<i>1002</i>

COPIED


MAY 2 - 1969

MISS. BD. OF
 WATER COMMISSIONERS

DRILLERS REMARKS: *This is a test hole to set little water pit. Present well in 2046 ft strata*

If well telescopes please sketch and show depths.

GROUND LEVEL

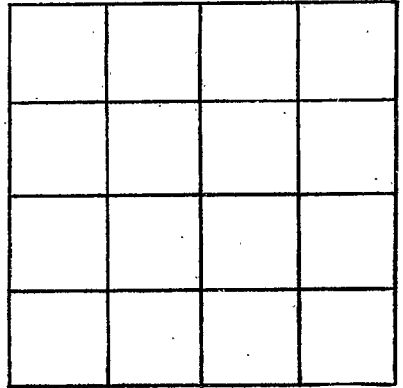

SECTION _____

Please indicate well location X.

ADDITIONAL INFORMATION

If more than one screen, show locations of each on sketch.