

Jeff Davis
 E17
 4-12-69

MISSISSIPPI
 BOARD OF WATER COMMISSIONERS
 416 North State Street
 Jackson, Mississippi 39201

WATER WELL DRILLERS LOG

4-12-1969 PRENTISS BUTANE JEFF DAVIS
 date well completed firm name county well located

LANDOWNER: BILLY RAY FORTNER
 ROUTE 3
 PRENTISS
 (mailing address)

Description of formations encountered	from	to
GRAVEL	0	30
CLAY	30	100
SAND	100	110

WELL LOCATION:
 sec. 19 T 7 N R 19 E
 S W
 1/2 miles S.W. of PRENTISS
 (distance) (direction) (nearest town)

WELL PURPOSE: HOME
 (home, irrigation, municipal, industrial)

- WELL COMPLETION DATA:
- (1) diameter (inches) 2"
 - (2) total depth (feet) 110'
 - (3) static water level (feet) 80' below top of ground
 - (4) casing PVC 110'
 (material) (depth)
 (size) If telescope see back.
 - (5) screen 5' 105'
 (length) (depth to top)
 2" PVC
 (size) (material)
 - (6) pump 3/4 HP 6.00
 (HP) (yield gpm)
 ELECTRIC
 (type power)
 - (7) electric log (yes or no)
 (organization running log)
 - (8) how well bottom plugged BWV

MAY 22 1969
 MAY 22 1969

MISS. BD. OF
 WATER COMM.

MAY 22 1969

MISS. BD. OF
 WATER COMM.


MAY 22 1969

MISS. BD. OF
 WATER COMM.

DRILLERS REMARKS:

If well telescopes please sketch and show depths.

GROUND LEVEL

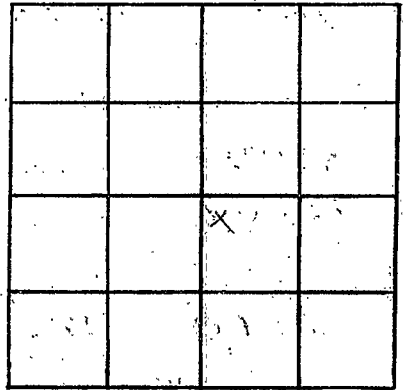

SECTION 19

Please indicate well location X.

ADDITIONAL INFORMATION

If more than one screen, show locations of each on sketch.