

Jeff Davis
 E23
 9-8-69

MISSISSIPPI
 BOARD OF WATER COMMISSIONERS
 416 North State Street
 Jackson, Mississippi 39201

CODED


WATER WELL DRILLERS LOG

9-8-1969 PRENTISS BUTANE JEFF DAVIS
 date well completed firm name county well located

LANDOWNER:	description of formations encountered	from	to
MARY HALL		GRAVEL & SAND	0
PRENTISS (mailing address)			
WELL LOCATION:			
sec. 7 T 20 S R 18 E (W)			
3 miles W of PRENTISS (distance) (direction) (nearest town)			
WELL PURPOSE: HOME (home, irrigation, municipal, industrial)			
WELL COMPLETION DATA:			
(1) diameter (inches) 2"			
(2) total depth (feet) 70			
(3) static water level (feet) 60 below above top of ground.			
(4) casing GAL (material), 65 (depth), (size) if telescope see back.			
(5) screen 3' (length), 65 (depth to top) 2 (size), 5.5 (material)			
(6) pump 3/4 (HP), 250 (yield gpm) ELECTRIC (type power)			
(7) electric log (yes or no)			
(organization running log)			
(8) how well bottom plugged B.W.V			
DRILLERS REMARKS:			
SEP 18 1969			
Mississippi State Board of Water Commissioners			

If well telescopes please sketch and show depths.

GROUND LEVEL

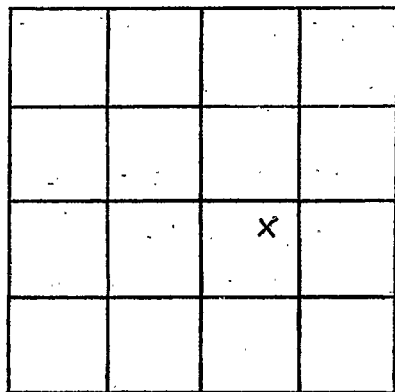

SECTION 7

Please indicate well location X.

ADDITIONAL INFORMATION

If more than one screen,
show locations of each on sketch.