

**MISSISSIPPI  
BOARD OF WATER COMMISSIONERS**  
416 North State Street  
Jackson, Mississippi 39201

**CODED**

**WATER WELL DRILLERS LOG**

Jeff Davis  
E 25  
10-69

10-18- 1969 PRENTISS BUTANE JEFF DAVIS  
date well completed firm name county well located


LANDOWNER:	description of formations encountered	from	to
<u>W. D. FORTENBERRY</u>		<u>GRAVEL</u>	<u>0</u>
<u>PRENTISS MISS.</u> (mailing address)	<u>SAND</u>	<u>100</u>	<u>120</u>
<b>WELL LOCATION:</b>			
sec. <u>29</u> T. <u>7</u> N. R. <u>19</u> E. S. <u>1</u> W.			
<u>6</u> miles <u>SW</u> of <u>PRENTISS</u> (distance) (direction) (nearest town)			
<b>WELL PURPOSE:</b> (home, irrigation, municipal, industrial)			
<b>WELL COMPLETION DATA:</b>			
(1) diameter (inches) <u>2</u>			
(2) total depth (feet) <u>120</u>			
(3) static water level (feet) <u>100</u> below above top of ground.			
(4) casing <u>P.V.V.</u> <u>115'</u> (material) (depth)			
_____ if telescope see back. (size)			
(5) screen <u>5</u> <u>115</u> (length) (depth to top)			
<u>2</u> <u>5.3</u> (size) (material)			
(6) pump <u>1 1/2</u> <u>525</u> (HP) (yield gpm)			
<u>ELECTRIC</u> (type power)			
(7) electric log (yes or no) _____			
_____ (organization running log)			
(8) how well bottom plugged <u>B.W.V.</u>			
<b>DRILLERS REMARKS:</b>			

**DEC 10 1969**

**FRANCIS ELL. CO.  
WATER WELL DRILLERS**

If well telescopes please  
sketch and show depths.

GROUND LEVEL

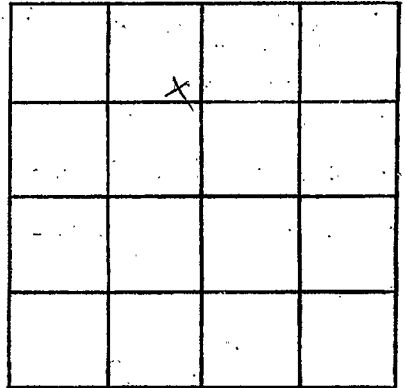

SECTION 29

Please indicate well location X.

ADDITIONAL INFORMATION

If more than one screen,  
show locations of each on sketch.