

Jeff Davis
E 26
11-69

MISSISSIPPI
BOARD OF WATER COMMISSIONERS
416 North State Street
Jackson, Mississippi 39201
WATER WELL DRILLERS LOG

CODED

11-24-1969 PRENTISS BUTANE GAS JEFF DAVIS
date well completed firm name county well located

LANDOWNER:	description of formations encountered	from	to
GARRAWAYS STORES			
PRENTISS MISS (mailing address)	CHALK	10	50
	SAND	50	120

WELL LOCATION:
sec. 8 T. 7^N S R. 19 E
4 miles W of PRENTISS
(distance) (direction) (nearest town)

WELL PURPOSE: HOME
(home, irrigation, municipal, industrial)

- WELL COMPLETION DATA:
- (1) diameter (inches) 2"
 - (2) total depth (feet) 120
 - (3) static water level (feet) 100 below top of ground.
 - (4) casing PVC, 115' (material) (depth)
(size) if telescope see back.
 - (5) screen 5' 115' (length) (depth to top)
(size) PVC (material)
 - (6) pump 3/4 420 (HP) (yield gpm)
 - ELECTRIC (type power)
 - (7) electric log (yes or no)
(organization running log)
 - (8) how well bottom plugged B.W.V


DRILLERS REMARKS:

DEC 10 1969

MISS. BD. OF WATER COMM.

If well telescopes please sketch and show depths.

GROUND LEVEL

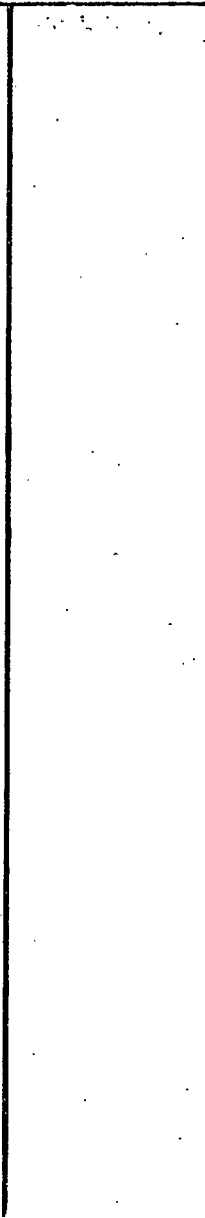


		X	

SECTION 8

Please indicate well location X.

ADDITIONAL INFORMATION

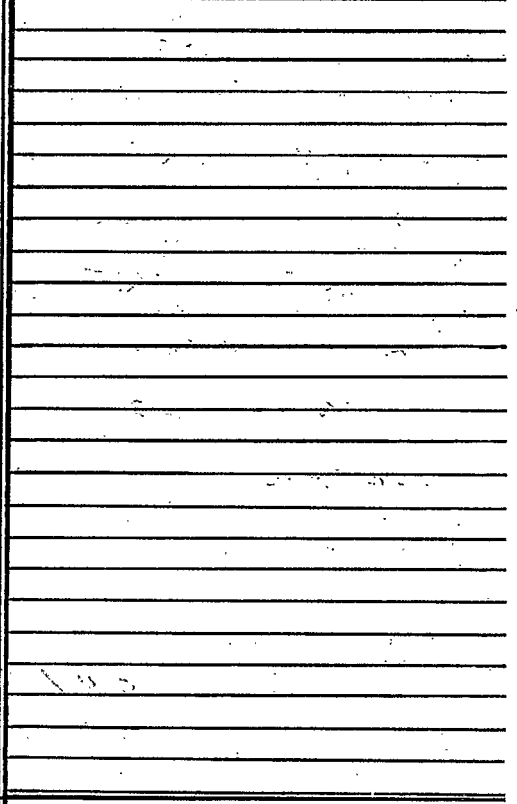

If more than one screen, show locations of each on sketch.